

JACKSON
M 2006
7-19-76

MISSISSIPPI
BOARD OF WATER COMMISSIONERS
416 North State Street
Jackson, Mississippi 39201

WATER WELL DRILLERS LOG

7/19 1976 Coast Water Well Service Jackson
date well completed firm name county well located

LANDOWNER: <u>Bill Elliott</u>	description of formations encountered	from	to
<u>Rt. 3</u>	<u>Top Soil</u>	<u>0</u>	<u>1</u>
<u>Pascagoula, MS, 39567</u> (mailing address)	<u>Red CLAY</u>	<u>1</u>	<u>14</u>
WELL LOCATION:	<u>Med SAND</u>	<u>14</u>	<u>22</u>
sec. <u>29</u> <u>6</u> N R. <u>5</u> E	<u>Coarse SAND & GRAVEL</u>	<u>22</u>	<u>71</u>
<u>8 1/2</u> miles <u>South</u> of <u>Men Pt.</u> (distance) (direction) (nearest town)	<u>Blue CLAY</u>	<u>71</u>	<u>122</u>
WELL PURPOSE: <u>Home</u> (home, irrigation, municipal, industrial)	<u>Med. SAND</u>	<u>122</u>	<u>145</u>
WELL COMPLETION DATA:	<u>Blue CLAY</u>	<u>145</u>	<u>152</u>
(1) diameter (inches) <u>2"</u>	<u>Med. SAND</u>	<u>152</u>	<u>205</u>
(2) total depth (feet) <u>270</u>	<u>Blue CLAY</u>	<u>205</u>	<u>223</u>
(3) static water level (feet) <u>10'</u> ^{below} / _{above} top of ground.	<u>Coarse SAND</u>	<u>223</u>	<u>270</u>
(4) casing <u>P.V.C.</u> , <u>260'</u> (material) (depth)			
<u>2"</u> (size) if telescope see back.			
(5) screen <u>10'</u> , <u>260'</u> (length) (depth to top)			
<u>2"</u> , <u>P.V.C.</u> (size) (material)			
(6) pump _____ (HP) (yield gpm)			
(type power)			
(7) electric log _____ (yes or no)			
(organization running log)			
(8) how well bottom plugged <u>B/W</u> <u>VALVE</u>			
DRILLERS REMARKS:			


RECEIVED

JAN 9 1977

PER COMM

If well telescopes please sketch and show depths.

GROUND LEVEL

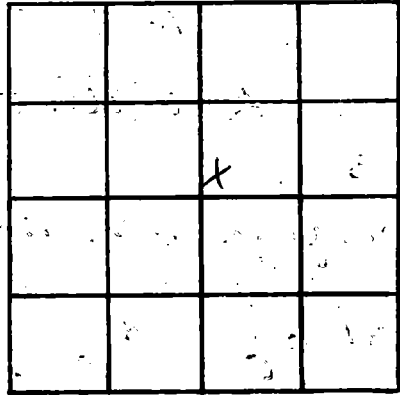

SECTION 29

Please indicate well location X.

ADDITIONAL INFORMATION

If more than one screen, show locations of each on sketch.