

JACKSON  
 M 2004  
 8/12/76

MISSISSIPPI  
 BOARD OF WATER COMMISSIONERS  
 416 North State Street  
 132 Jackson, Mississippi 39201

WATER WELL DRILLERS LOG

8-12 date well completed 19 76 Coast Water Well Drilling Co firm name Jackson county well located #1


LANDOWNER: <u>Austin Roberts</u>	description of formations encountered	from	to
<u>P.O. Box 441</u>	<u>Top Soil</u>	<u>0</u>	<u>2</u>
<u>Osceola, Mo.</u> (mailing address)	<u>Red Clay</u>	<u>2</u>	<u>8</u>
WELL LOCATION:	<u>Sand &amp; Gravel</u>	<u>8</u>	<u>66</u>
sec. <u>30</u> T. <u>6</u> R. <u>5</u>	<u>Blue Clay</u>	<u>66</u>	<u>100</u>
<u>1 1/2</u> miles <u>SW</u> of <u>Hellena</u> (distance) (direction) (nearest town)	<u>Med. Sand</u>	<u>100</u>	<u>130</u>
WELL PURPOSE: <u>None</u> (home, irrigation, municipal, industrial)			
WELL COMPLETION DATA:			
(1) diameter (inches) <u>2"</u>			
(2) total depth (feet) <u>130'</u>			
(3) static water level (feet) <u>5'</u> <u>below</u> <u>above</u> top of ground.			
(4) casing <u>P.V.C.</u> , <u>120'</u> (material) (depth) <u>2"</u> (size) if telescope see back.			
(5) screen <u>10'</u> , <u>120'</u> (length) (depth to top)			
<u>2"</u> , <u>P.V.C.</u> (size) (material)			
(6) pump <u>1/2</u> , <u>6 1/2</u> (HP) (yield gpm)			
<u>elec.</u> (type power)			
(7) electric log <u>—</u> (yes or no)			
<u>—</u> (organization running log)			
(8) how well bottom plugged <u>B/w</u> <u>valve</u>			
DRILLERS REMARKS:			

RECEIVED  
 MAR - 9 1977

OF WATER COMM

If well telescopes please sketch and show depths.

GROUND LEVEL

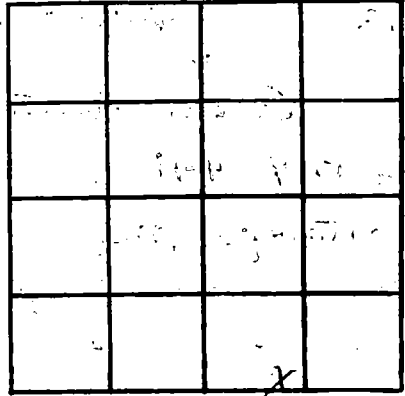

SECTION 30

Please indicate well location X.

ADDITIONAL INFORMATION

If more than one screen, show locations of each on sketch.