

JACKSON
 M 2011
 11-15-76

MISSISSIPPI
 BOARD OF WATER COMMISSIONERS
 416 North State Street
 Jackson, Mississippi 39201

WATER WELL DRILLERS LOG


11/15/76 date well completed 1976 Colville Drilling firm name Jackson county well located

LANDOWNER: <u>J. Harrison</u>	description of formations encountered	from	to
<u>Helena, MS</u> (mailing address)	<u>sandy clay</u>	<u>0</u>	<u>20</u>
WELL LOCATION: sec. <u>8</u> T. <u>6</u> N. R. <u>5</u> E <u>12</u> miles <u>W</u> of <u>Miss Point</u> (distance) (direction) (nearest town)	<u>soft shales</u>	<u>20</u>	<u>40</u>
WELL PURPOSE: <u>home</u> (home, irrigation, municipal, industrial)	<u>sand</u>	<u>40</u>	<u>125</u>
WELL COMPLETION DATA: (1) diameter (inches) <u>2</u>	<u>streaked</u>	<u>125</u>	<u>154</u>
(2) total depth (feet) <u>215</u>	<u>sand</u>	<u>154</u>	<u>215</u>
(3) static water level (feet) <u>18</u> <u>below</u> top of ground			
(4) casing <u>plast</u> , <u>210</u> (material) (depth)			
(5) screen <u>5'</u> , <u>210</u> (length) (depth to top)			
(6) pump <u>1/2</u> , <u>10 gpm</u> (HP) (yield gpm)			
(7) electric log <u>no</u> (yes or no)			
(8) how well bottom plugged <u>B.P. Valve</u>			
DRILLERS REMARKS:			

RECEIVED

If well telescopes please sketch and show depths.

GROUND LEVEL

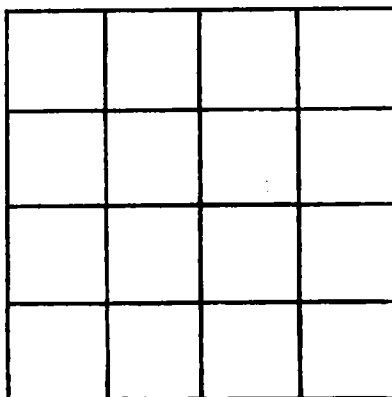

SECTION _____

Please indicate well location X.

ADDITIONAL INFORMATION

If more than one screen, show locations of each on sketch.