

JACKSON
M 7012
11/24/76

MISSISSIPPI
BOARD OF WATER COMMISSIONERS
416 North State Street
Jackson, Mississippi 39201

WATER WELL DRILLERS LOG

11/24 1976 COAST WATER WELL SERVICE INC. *Jackson*
date well completed firm name county well located

LANDOWNER: *Austin Robert*

description of formations encountered

from to

*P.O. Box 441
Escatawpa Miss 39552*
(mailing address)

Top Soil 0 8
White Coarse Sand + Gravel 8 114

WELL LOCATION:

sec. *30* T. *6* S. R. *5* W.
1 1/2 miles *SW* of *Helena*
(distance) (direction) (nearest town)

Blue Clay 114 139
Gray Coarse Sand 139 150

WELL PURPOSE: *None*
(home, irrigation, municipal, industrial)

WELL COMPLETION DATA:

- (1) diameter (inches) *2"*
- (2) total depth (feet) *150'*
- (3) static water level (feet) *17'* ^{below} _{above} top of ground.
- (4) casing *PVC*, *140'*
(material) (depth)
- 2*
(size) If telescope see back.
- (5) screen *10*, *140'*
(length) (depth to top)
- 2*, *PVC*
(size) (material)
- (6) pump *1/2 hp.*, *7 1/2*
(HP) (yield gpm)
- Elect.*
(type power)
- (7) electric log *No.*
(yes or no)

(organization running log)

(8) how well bottom plugged *AW Valve*


RECEIVED
MAR - 9 1977

DRILLERS REMARKS:

MISS. BD. OF WATER COMM

If well telescopes please sketch and show depths.

GROUND LEVEL

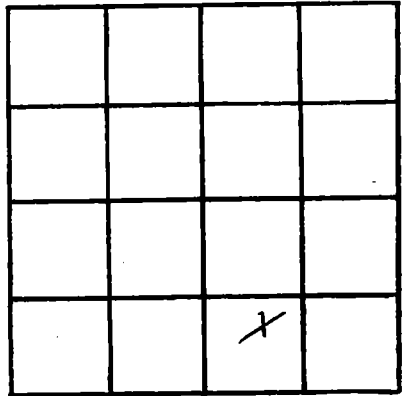

SECTION 30

Please indicate well location X.

ADDITIONAL INFORMATION

If more than one screen, show locations of each on sketch.