

JACKSON
M 9013
1-14-77

MISSISSIPPI
BOARD OF WATER COMMISSIONERS
416 North State Street
Jackson, Mississippi 39201

WATER WELL DRILLERS LOG
COAST WATER WELL SERVICE

1-14
date well completed

1977

firm name

Jackson
county well located

LANDOWNER: P. Wrenford Jones
Box 1347
Pascagoula, Miss
(mailing address) 39567

description of formations encountered	from	to
top soil	0	1
red clay	1	8
coarse sand	8	35
blue clay	35	100
red sand	100	148

WELL LOCATION:

sec. 31 T. 6 N. R. 5 W.
3 miles N. of Pascagoula
(distance) (direction) (nearest town)

WELL PURPOSE: Home
(home, irrigation, municipal, industrial)

WELL COMPLETION DATA:

- (1) diameter (inches) 2
- (2) total depth (feet) 148
- (3) static water level (feet) 10 below above
top of ground.
- (4) casing PVC 138
(material) (depth)
2 If telescope see back.
(size)
- (5) screen 10 138
(length) (depth to top)
2 PVC
(size) (material)
- (6) pump 1 hp Elect
(hp) (yield gpm)
(type power)
- (7) electric log No
(yes or no)

(organization running log)

(8) how well bottom plugged back wash
Value


DRILLERS REMARKS:

RECEIVED
MAR - 9 1977

MISS. Bd. OF WATER COMMISSIONERS

If well telescopes please sketch and show depths.

GROUND LEVEL

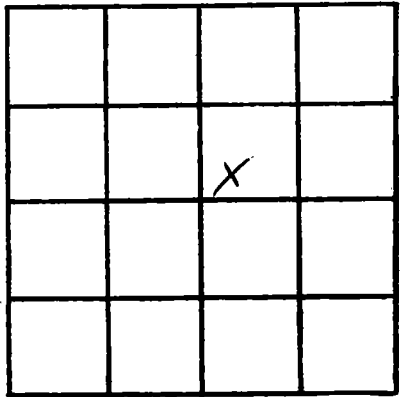

SECTION 31

Please indicate well location X.

ADDITIONAL INFORMATION

If more than one screen, show locations of each on sketch.