

JACKSON
M 2014
1-24-77

MISSISSIPPI
BOARD OF WATER COMMISSIONERS
416 North State Street
Jackson, Mississippi 39201

WATER WELL DRILLERS LOG

Jan 24 1977 Colville Drilling Co. Jackson
date well completed firm name county well located

LANDOWNER: Bill Nelson

description of formations encountered	from	to
clay	0	15
sand	15	65
clay	65	82
sand	82	120
clay	120	150
sand	150	180
clay	180	200
sand TD	200	261

Helena Mo.
(mailing address)

WELL LOCATION:

sec. 29 T. 6 N R. 5 E
0 2 miles NE of MP.
(distance) (direction) (nearest town)

WELL PURPOSE: Home
(home, irrigation, municipal, industrial)

WELL COMPLETION DATA:

- (1) diameter (inches) 2 in
- (2) total depth (feet) 261
- (3) static water level (feet) 5 ft below top of ground
- (4) casing plastic 25 ft (material) (depth)
2 in if telescope see back (size)
- (5) screen 5 ft - 25 ft (length) (depth to top)
2 in plastic (size) (material)
- (6) pump 1/2 (HP) 6 (yield gpm)
elec (type power)
- (7) electric log no (yes or no)
(organization running log)
- (8) how well bottom plugged BP valve


RECEIVED
MAR 14 1977

DRILLERS REMARKS:

MISS. BD. OF WATER COMMISSIONERS

If well telescopes please sketch and show depths.

GROUND LEVEL

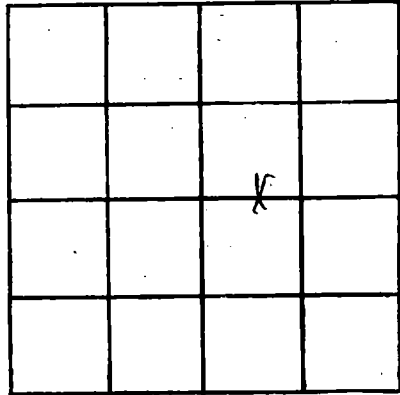

SECTION 29

Please indicate well location X.

ADDITIONAL INFORMATION

If more than one screen, show locations of each on sketch.