

JACKSON
M 2016
3-8-77

MISSISSIPPI
 BOARD OF WATER COMMISSIONERS
 416 North State Street
 Jackson, Mississippi 39201

WATER WELL DRILLERS LOG

3-8 ^{13R} 1977 Coast Water Well Serv Jackson
 date well completed firm name county well located

LANDOWNER: Mike Signor
Rt. 3, Box 191-7
Passagoula MS 39567
 (mailing address)

description of formations encountered	from	to
<u>top soil</u>	<u>0</u>	<u>1</u>
<u>red clay</u>	<u>1</u>	<u>8</u>
<u>Med. Sand</u>	<u>8</u>	<u>25</u>
<u>clay</u>	<u>25</u>	<u>70</u>
<u>med to coarse sand</u>	<u>70</u>	<u>107</u>

WELL LOCATION:
 sec. 10 T 6 R 5
2 1/2 miles N.E. of Helena
 (distance) (direction) (nearest town)

WELL PURPOSE: home
 (home, irrigation, municipal, industrial)

- WELL COMPLETION DATA:
- (1) diameter (inches) 2"
 - (2) total depth (feet) 107'
 - (3) static water level (feet) 15 ^{below} _{above} top of ground.
 - (4) casing PVC, 97'
 (material) (depth)
2" If telescope see back.
 (size)
 - (5) screen 10', 97'
 (length) (depth to top)
2", PVC
 (size) (material)
 - (6) pump _____
 (HP) (yield gpm)

 (type power)
 - (7) electric log NO
 (yes or no)


 (organization running log)
 - (8) how well bottom plugged B/w valve

DRILLERS REMARKS:

RECEIVED
 MAR 11 1977

If well telescopes please sketch and show depths.

GROUND LEVEL

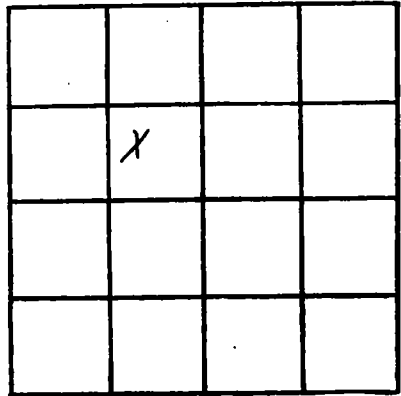

SECTION 10

Please indicate well location X.

ADDITIONAL INFORMATION

If more than one screen,
show locations of each on sketch.