

JACKSON
M 209
4-15-77

MISSISSIPPI
BOARD OF WATER COMMISSIONERS
416 North State Street
130 Jackson, Mississippi 39201

WATER WELL DRILLERS LOG

4-15 date well completed 19 77 Coast Water Well Sew firm name Jackson county well located

LANDOWNER Blair P. Brown
2002 Woodlawn
Moss Point, Miss 39563
(mailing address)

description of formations encountered	from	to
Grey Clay	0	10'
Sand Gravel	10'	74'
Blue Clay	74'	165'
Sand - (inc.)	165'	210'

WELL LOCATION:
sec. 32 T 6 R 5
4 miles N.E. of Ecataumpa
(distance) (direction) (nearest town)

WELL PURPOSE: Supply
(home, irrigation, municipal, industrial)

WELL COMPLETION DATA:
(1) diameter (inches) 2"
(2) total depth (feet) 210'
(3) static water level (feet) 20' below top of ground.
(4) casing PVC 200' (material) (depth)
2 (size) if telescope see back.
(5) screen 10' 200' (length) (depth to top)
2 (size) PVC (material)
(6) pump 1 hp 9 (HP) (yield gpm)
blue (type power)
(7) electric log No. (yes or no)
(organization running log)
(8) how well bottom plugged Backwash valve


DRILLERS REMARKS:

RECEIVED

SEP 21 1977

If well telescopes please sketch and show depths.

GROUND LEVEL

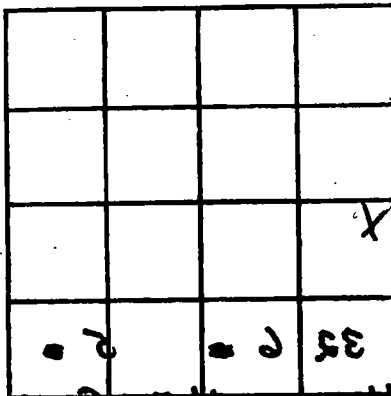

SECTION 32

Please indicate well location X.

ADDITIONAL INFORMATION

P

If more than one screen, show locations of each on sketch.