

Phone - 475-4843

JACKSON
M 2020
4-26-77

MISSISSIPPI
BOARD OF WATER COMMISSIONERS
416 North State Street
Jackson, Mississippi 39201

WATER WELL DRILLERS LOG

4-26-77 ^{13R} Count Water Well Serv. Jackson
date well completed firm name county well located

LANDOWNER:
Ronnie Hudson
Box 1 Box 657
Pascagoula Miss.
(mailing address)

WELL LOCATION:
sec. 32 T 6 S R 4 E
11 miles N.E. of Pascagoula
(distance) (direction) (nearest town)

WELL PURPOSE: Home
(home, irrigation, municipal, industrial)

WELL COMPLETION DATA:
(1) diameter (inches) 2"
(2) total depth (feet) 400'
(3) static water level (feet) 20' ^{below} _{above} top of ground.
(4) casing PVC 380'
(material) (depth)
2" If telescope see back.
(size)
(5) screen 20' 380'
(length) (depth to top)
2" P.V.C.
(size) (material)
(6) pump None 45 FLOW.
(HP) (yield gpm)
Elec.
(type power)
(7) electric log _____
(yes or no)

(organization running log)
(8) how well bottom plugged Back flush valve


description of formations encountered	from	to
<u>Top Soil</u>	<u>0</u>	<u>8</u>
<u>fine sand</u>	<u>8</u>	<u>20</u>
<u>blue clay</u>	<u>20</u>	<u>55</u>
<u>Med. sand</u>	<u>55</u>	<u>75</u>
<u>blue clay</u>	<u>75</u>	<u>90</u>
<u>Med to coarse sand</u>	<u>90</u>	<u>150</u>
<u>blue clay + shell</u>	<u>150</u>	<u>290</u>
<u>Med to coarse sand + gravel</u>	<u>290</u>	<u>400</u>

DRILLERS REMARKS:

RECEIVED
SEP 21 1977

If well telescopes please sketch and show depths.

GROUND LEVEL

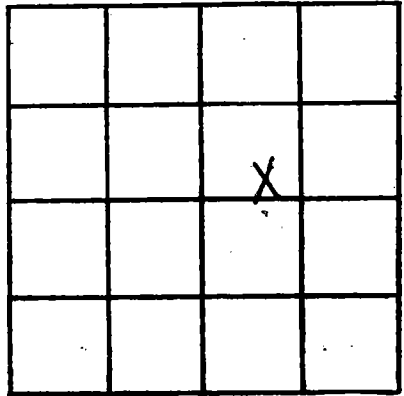

SECTION 32

Please indicate well location X.

ADDITIONAL INFORMATION

If more than one screen,
show locations of each on sketch.