

JACKSON
M 2023
7-3-77

MISSISSIPPI
BOARD OF WATER COMMISSIONERS
416 North State Street
Jackson, Mississippi 39201

WATER WELL DRILLERS LOG

July 3, 1977 ¹³² Colville Drilling Co Jackson County
date well completed firm name county well located

LANDOWNER: <u>Doc Comers</u> <u>Big Bend</u> (mailing address)	description of formations encountered	from	to
WELL LOCATION: sec. <u>3</u> T. <u>16</u> N R. <u>5</u> E <u>11</u> miles <u>N</u> of <u>MP</u> (distance) (direction) (nearest town)	fine clay	0	15
WELL PURPOSE: <u>Home</u> (home, irrigation, municipal, industrial)	sand	15	22
WELL COMPLETION DATA: (1) diameter (inches) <u>2in</u>	sand	22	44
(2) total depth (feet) <u>215</u>	sand	44	66
(3) static water level (feet) <u>10'</u> <u>below</u> top of ground.	sand	66	88
(4) casing <u>plastic</u> , <u>2in</u> , (material) (depth)	sand	88	110
<u>2in</u> If telescope see back. (size)	sand	110	126
(5) screen <u>5ft</u> , <u>210'</u> (length) (depth to top)	clay	126	132
<u>2in</u> , <u>plastic</u> (size) (material)	clay	132	154
(6) pump <u>3/4</u> , <u>12</u> (HP) (yield gpm)	sand	154	176
<u>elect</u> (type power)	sand	176	180
(7) electric log <u>no</u> (yes or no)	sand	180	198
(8) how well bottom plugged _____	sand	198	215
_____	mud		
(organization running log)			
(8) how well bottom plugged _____			
DRILLERS REMARKS: _____			


RECEIVED

JUL 28 1977

MISS. BD. OF WATER COMM

If well telescopes please sketch and show depths.

GROUND LEVEL

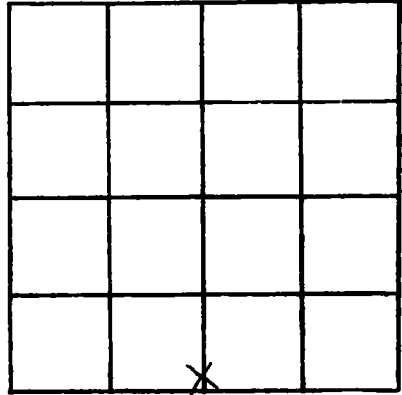

SECTION 8

Please indicate well location X.

ADDITIONAL INFORMATION

If more than one screen, show locations of each on sketch.