

JACKSON

M 2032

MISSISSIPPI BOARD OF WATER COMMISSIONERS
416 North State Street
Jackson, Mississippi 39201

WATER WELL DRILLERS LOG

4-5-78
date well completed

Coast Water Well Serv., Inc
firm name

Jackson
county well located

LANDOWNER:

Quon Versiga
P.O. Box 1546
Pasadena, Miss 39567
(mailing address)

description of formations encountered

from to

Top soil	0	3
Red Clay	3	10
Sand - gravel	10	80
Blue Clay	80	100
Sand (mc)	100	120
Blue Clay	120	180
Sand (m)	180	210
Blue Clay	210	260
Sand (m)	260	278

WELL LOCATION:

sec. 30 T-6 R-5
miles 1.5 of Pasadena
(distance) (direction) (nearest town)

WELL PURPOSE:

(home, irrigation, municipal, industrial)

WELL COMPLETION DATA:

- (1) diameter (inches) 2"
- (2) total depth (feet) 278'
- (3) static water level (feet) 20' ^{below}/_{above} top of ground
- (4) casing P.V.C., 268'
(material) (depth)
2" if telescope see back.
(size)
- (5) screen 10', 268'
(length) (depth to top)
2", P.V.C.
(size) (material)
- (6) pump 1/2 hp., ?
(HP) (yield gpm)
- (7) electric log No.
(yes or no)

(organization running log)

(8) how well bottom plugged
backwash valve

DRILLERS REMARKS:


RECEIVED

AUG - 3 1978

MISS. BOARD OF WATER COMMISSIONERS

If well telescopes please sketch and show depths.

GROUND LEVEL

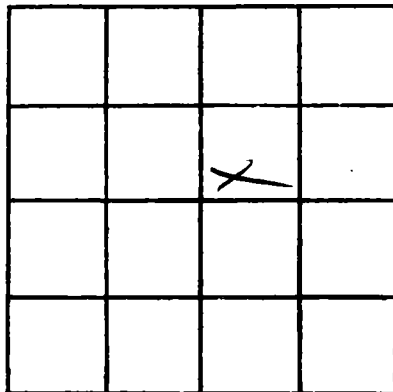

SECTION 30

Please indicate well location X.

ADDITIONAL INFORMATION

If more than one screen,
show locations of each on sketch.