

MISSISSIPPI DEPARTMENT OF NATURAL RESOURCES

Bureau of Land and Water Resources

Southport Mall

P.O. Box 10631

Jackson, Mississippi 39209

WATER WELL DRILLERS LOG

Jackson  
M 7037  
8-7-81

8-7-1981 date well completed  
81 Coast Water Well Sew. Jackson firm name  
Jackson county well located

LANDOWNER: Lester Boykin  
Rt 3 - Box 116,  
Pascagoula Miss.  
(mailing address) 39567

description of formations encountered	from	to
Top soil	0	5'
R. Clay	5'	15'
G. Clay - Sand - c.	15'	40'
Q. Sand - g.	40'	120'
Blue Clay	120'	185'
M. Sand	185'	220'


WELL LOCATION:  
sec. 8 T. 6 R. 5  
4 miles S of Big Point  
(distance) (direction) (nearest town)

WELL PURPOSE: None  
(home, irrigation, municipal, industrial)

- WELL COMPLETION DATA:
- (1) diameter (inches) 2"
  - (2) total depth (feet) 220'
  - (3) static water level (feet) 18' below top of ground.
  - (4) casing Pvc 10'  
(material) (depth)
  - 2" If telescope see back.  
(size)
  - (5) screen 10' 210'  
(length) (depth to top)
  - 2" PVC  
(size) (material)
  - (6) pump 1/2 6  
(HP) (yield gpm)
  - Elec.  
(type power)
  - (7) electric log No.  
(yes or no)
  - (organization running log)


(8) How well bottom plugged  
Back Wash Valve

DRILLERS REMARKS:

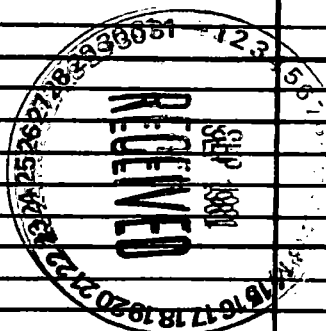

If well telescopes please sketch and show depths.

GROUND LEVEL

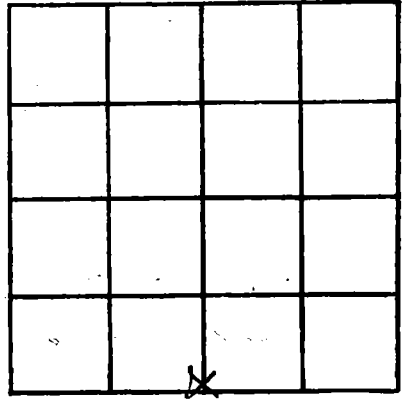

SECTION 8

Please indicate well location X.

ADDITIONAL INFORMATION

If more than one screen, show locations of each on sketch.