

JACKSON

M 2838

6-27-78

MISSISSIPPI BOARD OF WATER COMMISSIONERS
416 North State Street
Jackson, Mississippi 39201

WATER WELL DRILLERS LOG

6-27-78 date well completed
1978 Crest Water Well Serv. Inc. firm name
Jackson county/well located

LANDOWNER: Greater Port of Pascagoula
P.O. Box 878
Pascagoula, Miss.
(mailing address) 39567

description of formations encountered	from	to
Top soil	0	5
Red Clay	5	30
Sand (mc)	30	45
gray clay	45	55
Sand gravel	55	120
Blue Clay	120	267
Sand (mc)	267	298

WELL LOCATION:

sec. 7 T-6 R-5
4 miles West of Big Point
(distance) (direction) (nearest town)

WELL PURPOSE:
(home, irrigation, municipal, industrial)

WELL COMPLETION DATA:

- (1) diameter (inches) 4" x 2"
 - (2) total depth (feet) 298'
 - (3) static water level (feet) 20' ^{below}/_{above} top of ground.
 - (4) casing PVC (material), 288' (depth)
4" x 2" (size) if telescope see back.
 - (5) screen 10' (length), 288' (depth to top)
2" (size), 5. Steel (material)
 - (6) pump 1 (HP), 18 (yield gpm)
Elect. (type power)
 - (7) electric log No (yes or no)
- (organization running log)

(8) how well bottom plugged
Back Wash Valve


DRILLERS REMARKS:

RECEIVED
NOV - 9 1978

MISS. BD. OF WATER COMM

If well telescopes please sketch and show depths.

GROUND LEVEL

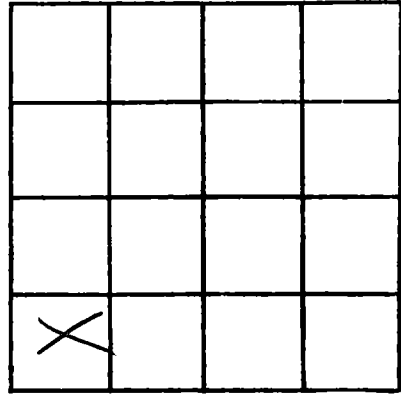

SECTION 2

Please indicate well location X.

ADDITIONAL INFORMATION

If more than one screen, show locations of each on sketch.