

JACKSON

M 2043

11-01-78

MISSISSIPPI BOARD OF WATER COMMISSIONERS 416 North State Street Jackson, Mississippi 39201

WATER WELL DRILLERS LOG

Nov. 1 1978 T.V. Colwell Drilling Co. Jackson date well completed firm name county well located

LANDOWNER: R.M. Roberts

description of formations encountered from to

Franklin Creek (mailing address)

Table with 3 columns: description of formations encountered, from, to. Rows include: sandy clay, sand, clay, clay, otk, otk, sand, sand, clay, otk, otk, clay, clay, clay, sand, sand, very fine sand, sand.

WELL LOCATION:

sec. 32 T. 6 N. R. 4 E. 10 miles NE of Mossburn (distance) (direction) (nearest town)

WELL PURPOSE: home (home, irrigation, municipal, industrial)

WELL COMPLETION DATA:

- (1) diameter (inches) 2
(2) total depth (feet) 395 ft
(3) static water level (feet) 116 below top of ground
(4) casing plastic, 390 (material) (depth)
(5) screen 5' 390 (length) (depth to top) 2 inch stainless (size) (material)
(6) pump 1/2 10 (HP) (yield/gpm) electric (type power)
(7) electric log no (yes or no)
(8) how well bottom plugged RP valve

RECEIVED


JAN 9 1978

MISS. BD. OF WATER COMM

DRILLERS REMARKS:

If well telescopes please sketch and show depths.

GROUND LEVEL

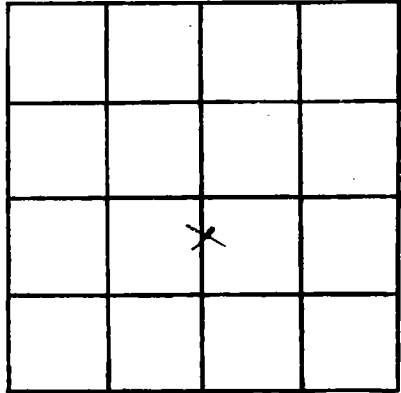

SECTION 82

Please indicate well location X.

ADDITIONAL INFORMATION

Lined area for additional information.

If more than one screen, show locations of each on sketch.