

JACKSON
M 2048
2-27-79

MISSISSIPPI
BOARD OF WATER COMMISSIONERS
416 North State Street
Jackson, Mississippi 39201

WATER WELL DRILLERS LOG

2-27 1979 Cross Water Well Serv. Inc. Jackson
date well completed firm name county well located

LANDOWNER: Wayne Lopez
Rt. 3 - Box 362,
Pascagoula, Miss.
(mailing address) 39267

description of formations encountered	from	to
<u>Top soil</u>	<u>0</u>	<u>3</u>
<u>Red Clay</u>	<u>3</u>	<u>10</u>
<u>gray Clay, shue</u>	<u>10</u>	<u>45</u>
<u>Sand (m)</u>	<u>45</u>	<u>66</u>
<u>Blue Clay</u>	<u>66</u>	<u>110</u>
<u>Sand (m)</u>	<u>110</u>	<u>140</u>

WELL LOCATION:
sec. 27 T 6 R 5
5 miles N. East of Escatawpa
(distance) (direction) (nearest town)

WELL PURPOSE: Home
(home, irrigation, municipal, industrial)

- WELL COMPLETION DATA:
- (1) diameter (inches) 2"
 - (2) total depth (feet) 140'
 - (3) static water level (feet) 10' below top of ground.
 - (4) casing PVC 130'
(material) (depth)
2" if telescope see back.
(size)
 - (5) screen 10' 130'
(length) (depth to top)
2" PVC
(size) (material)
 - (6) pump 1 hp. 10
(HP) (yield gpm.)
Elect.
(type power)
 - (7) electric log No
(yes or no)

(organization running log)

(8) how well bottom plugged
backwash valve

DRILLERS REMARKS:


Miss. Board of Water Comm.

MAY 29 1979

RECEIVED

If well telescopes please sketch and show depths.

GROUND LEVEL

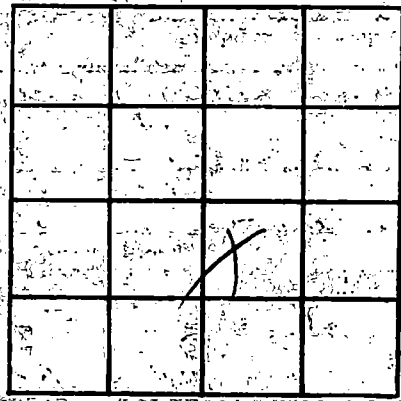

SECTION 27

Please indicate well location X.

ADDITIONAL INFORMATION

If more than one screen, show locations of each on sketch.