

JACKSON
M 2049
2-28-79

MISSISSIPPI
BOARD OF WATER COMMISSIONERS
416 North State Street
Jackson, Mississippi 39201

WATER WELL DRILLERS LOG

2-28-1979 date well completed
1979 Cross Water Well Sew. Inc. firm name
Jackson county well located

LANDOWNER: John Pemberton
and co Construction Co.
P.O. Box 5037 - Keesler Station
Miss Brook, Miss. 39563-
(mailing address)

description of formations encountered	from	to
Top soil	0	2
Red Clay	2	30
Sand (c)	30	40
Blue Clay	40	54
Sand Gravel	54	100
Blue Clay	100	160
Sand (m)	160	190

WELL LOCATION:
sec. 7 T. 6 R. 5
6 miles North of Escatawpa
(distance) (direction) (nearest town)

WELL PURPOSE: Home
(home, irrigation, municipal, industrial)

- WELL COMPLETION DATA:
- (1) diameter (inches) 2"
 - (2) total depth (feet) 190'
 - (3) static water level (feet) 20' below top of ground
 - (4) casing PVC 180'
(material) (depth)
2" if telescope see back.
(size)
 - (5) screen 10' 180'
(length) (depth to top)
2" PVC
(size) (material)
 - (6) pump 1/2 H.P. 7 1/2
(HP) (yield gpm)
Check
(type power)
 - (7) electric log No
(yes or no)
- (organization running log)

(8) how well bottom plugged
back wash valve

DRILLERS REMARKS:


Miss. Board of Water Comm.

MAY 29 1979

RECEIVED

If well telescopes please sketch and show depths.

GROUND LEVEL

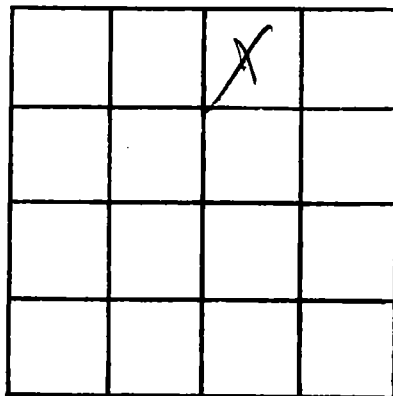

SECTION 7

Please indicate well location X.

ADDITIONAL INFORMATION

If more than one screen, show locations of each on sketch.