

JACKSON  
M 2050  
3-22-79

MISSISSIPPI  
BOARD OF WATER COMMISSIONERS  
416 North State Street  
Jackson, Mississippi 39201

WATER WELL DRILLERS LOG

3-22-1979 date well completed  
79 Coast Water Well Service firm name  
Jackson county well located

LANDOWNER: James Freeman

description of formations encountered

from to

1505 Gray Rd.  
Bucannon, Miss.  
(mailing address) 39167

Sandy Top soil	0	8
Gray Clay	8	40
Sand Gravel	40	55
Blue Clay	55	122
Sand (M)	122	135

WELL LOCATION:

sec. 34 T 6 N R 5 E  
2 miles North of Moss Point  
(distance) (direction) (nearest town)

WELL PURPOSE:  
(home, irrigation, municipal, industrial)

WELL COMPLETION DATA:

- (1) diameter (inches) 2"
  - (2) total depth (feet) 135'
  - (3) static water level (feet) 20' below surface top of ground.
  - (4) casing PVC, 125' (material) (depth)  
2" (size) if telescope see back.
  - (5) screen 10' 125' (length) (depth to top)  
2" PVC (size) (material)
  - (6) pump 1 h.p. 9 (HP) (yield gpm)  
Elex (type power)
  - (7) electric log No (yes or no)
- (organization running log)

(8) how well bottom plugged  
back wash valve

DRILLERS REMARKS:


Miss. Board of Water Comm.

MAY 29 1979

RECEIVED

If well telescopes please sketch and show depths.

GROUND LEVEL

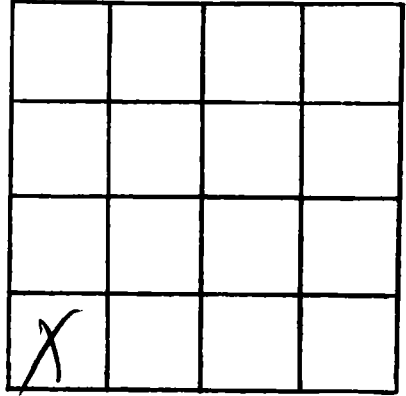

SECTION 34

Please indicate well location X.

ADDITIONAL INFORMATION

If more than one screen, show locations of each on sketch.