

MISSISSIPPI
 BOARD OF WATER COMMISSIONERS
 416 North State Street
 Jackson, Mississippi 39201

WATER WELL DRILLERS LOG

Jackson
M 2052
4-10-79

4110 1979 Price Pulling Co. Jackson
 date well completed firm name county well located

LANDOWNER: Grady Ely
Ret.
Lucedale Ms
 (mailing address)

description of formations encountered	from	to
<u>TOP SOIL</u>	<u>0</u>	<u>10</u>
<u>GOOD SAND</u>	<u>10</u>	<u>25</u>
<u>CLAY</u>	<u>25</u>	<u>100</u>
<u>GOOD SAND</u>	<u>100</u>	<u>130</u>

WELL LOCATION:
 ? sec. 17 T. 6 N. R. 5 E
30 miles South of Lucedale
 (distance) (direction) (nearest town)

WELL PURPOSE:
 (home, irrigation, municipal, industrial)

- WELL COMPLETION DATA:
- diameter (inches) 2 1/4
 - total depth (feet) 130
 - static water level (feet) 50 ^{below} above top of ground.
 - casing Plastic 120
 (material) (depth)
0 If telescope see back.
 (size)
 - screen 10 130
 (length) (depth to top)
0/10 PLASTIC
 (size) (material)
 - pump 1 10
 (HP) (yield gpm)
GLU
 (type power)
 - electric log yes or no
- (organization running log)
- (8) how well bottom plugged BL

DRILLERS REMARKS:


Miss. Board of Water Comm.

MAY 31 1979

RECEIVED

If well telescopes please sketch and show depths.

GROUND LEVEL

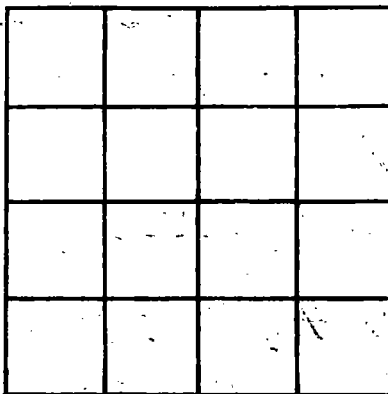

SECTION _____

Please indicate well location X.

ADDITIONAL INFORMATION

A series of 18 horizontal lines providing space for additional information.

If more than one screen, show locations of each on sketch.