

JACKSON  
 M 2055  
 8-21-79

MISSISSIPPI  
 BOARD OF WATER COMMISSIONERS  
 416 North State Street  
 Jackson, Mississippi 39201

WATER WELL DRILLERS LOG

Aug 21 1979 *Duff Well Co* *Jackson*  
 date well completed firm name county well located

LANDOWNER: <i>John Nulty</i>	description of formations encountered	from	to
<i>Miss Point Miss</i> (mailing address)	<i>gray sand</i>	<i>0</i>	<i>8</i>
	<i>Clay</i>	<i>8</i>	<i>15</i>
WELL LOCATION: sec <i>4</i> T <i>6</i> N R <i>5</i> E <i>1/2</i> miles <i>NO</i> of <i>Hickman</i> (distance) (direction) (nearest town)	<i>sand</i>	<i>15</i>	<i>25</i>
WELL PURPOSE: <i>Home</i> (home, irrigation, municipal, industrial)	<i>Blue clay</i>	<i>20</i>	<i>45</i>
WELL COMPLETION DATA: (1) diameter (inches) <i>2"</i> (2) total depth (feet) <i>25'</i> (3) static water level (feet) <i>7</i> <input checked="" type="checkbox"/> below <input type="checkbox"/> above top of ground. (4) casing <i>PVC</i> <i>20'</i> (material) (depth) (size) if telescope see back. (5) screen <i>5'</i> <i>20'</i> (length) (depth to top) <i>2"</i> <i>PVC</i> (size) (material) (6) pump <i>1</i> <i>12</i> (HP) (yield gpm) <i>ele</i> (type power) (7) electric log <i>no</i> (yes or no) (organization running log) (8) how well bottom plugged <i>B. up</i>	<i>sand</i>	<i>40</i>	<i>25</i>
DRILLERS REMARKS:			


Miss. Board of Water Comm.

SEP 4 1979

RECEIVED

If well telescopes please sketch and show depths.

GROUND LEVEL

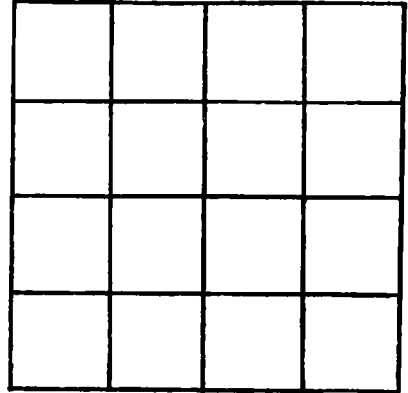

SECTION \_\_\_\_\_

Please indicate well location X.

ADDITIONAL INFORMATION

If more than one screen,  
show locations of each on sketch.