

JACKSON
~~10-3-79~~
 10-3-79

MISSISSIPPI
 BOARD OF WATER COMMISSIONERS
 416 North State Street
 Jackson, Mississippi 39201

WATER WELL DRILLERS LOG

10-3-79 1979 Pwice Pullinger Jackson
 date well completed firm name county well located

LANDOWNER: Sen Valley Helena
Procapaula Mrs.
 (mailing address)

description of formations encountered	from	to
TOP SOIL	0	15
SANDY CLAY	15	26
GOOD SAND	29	80
CLAY	80	126
GOOD SAND	126	146

WELL LOCATION:
 sec. 28 T. 69 R. 5
25 miles South of Shubal
 (distance) (direction) (nearest town)

WELL PURPOSE:
 (home, irrigation, municipal, industrial)

WELL COMPLETION DATA:
 (1) diameter (inches) 2"
 (2) total depth (feet) 140'
 (3) static water level (feet) 26 ^{below} above top of ground
 (4) casing PLASTIC 130'
 (material) (depth)
0 (size) if telescope see back.
 (5) screen 10' / 140'
 (length) (depth to top)
010, PLASTIC
 (size) (material)
 (6) pump 1 10
 (HP) (yield gpm)
Electric
 (type power)
 (7) electric log (yes or no)
 (organization running log)
 (8) how well bottom plugged B.W.

DEPT. OF NATURAL RESOURCES
 BUREAU OF LAND & WATER RESOURCES


OCT 19 1979

RECEIVED

DRILLERS REMARKS: _____

If well telescopes please sketch and show depths.

GROUND LEVEL

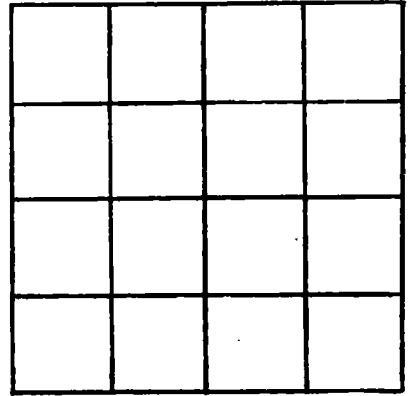

SECTION _____

Please indicate well location X.

ADDITIONAL INFORMATION

If more than one screen, show locations of each on sketch.