

JACKSON
M 2059
7-20-79

MISSISSIPPI
BOARD OF WATER COMMISSIONERS
416 North State Street
Jackson, Mississippi 39201

WATER WELL DRILLERS LOG

7-20-1979 *Coastal Water Well Serv. Inc.* Jackson
date well completed firm name county well located

LANDOWNER: *Paul Poole*
934 Echan Allen St.
Pascagoula, Miss.
(mailing address)

description of formations encountered	from	to
<i>Top soil</i>	<i>0</i>	<i>1</i>
<i>Red Clay</i>	<i>1</i>	<i>10</i>
<i>Sand @</i>	<i>10</i>	<i>74</i>
<i>Blue Clay</i>	<i>74</i>	<i>127</i>

WELL LOCATION:
sec. *32* T. *6* S. E. *4* R. *4* E.
8 1/2 miles *M. West* of *Escatawpa*
(distance) (direction) (nearest town)

WELL PURPOSE: *Home*
(home, irrigation, municipal, industrial)

WELL COMPLETION DATA:

(1) diameter (inches) *2"*

(2) total depth (feet) *147'*

(3) static water level (feet) *5'* ^{below} ~~above~~ top of ground.

(4) casing *PVC*, *137'*
(material) (depth)
2"
(size) if telescope see back.

(5) screen *10'*, *137'*
(length) (depth to top)
2", *PVC*
(size) (material)

(6) pump *1/2 hp.*, *-6-*
(HPY) (yield gpm)
Elect.
(type power)

(7) electric log *No.*
(yes or no)

(organization running log)

(8) how well bottom plugged *back wash valve*

DRILLERS REMARKS:


DEPT. OF NATURAL RESOURCES
BUREAU OF LAND & WATER RESOURCES

FEB 26 1980

RECEIVED

If well telescopes please sketch and show depths.

GROUND LEVEL

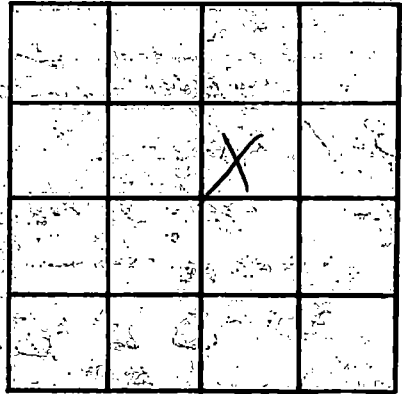

SECTION 32

Please indicate well location X.

ADDITIONAL INFORMATION

If more than one screen, show locations of each on sketch.