

JACKSON
M 7069
8-15-80

MISSISSIPPI
BOARD OF WATER COMMISSIONERS
416 North State Street
Jackson, Mississippi 39201

*1055 L...
...
...
...*

WATER WELL DRILLERS LOG

8-15 1980 Engage Well Service firm name
date well completed county well located

LANDOWNER: Rickey Harmon

description of formations encountered	from	to
Top Soil	0	10
Sand	10	20
Beach Clay	20	30
Sand	30	40
Cypress tree	40	42
Sand	42	50
Sand	50	70

(mailing address)

WELL LOCATION:
sec. 1 T. 6 N R. 5 E
4 miles S of Big Point
(distance) (direction) (nearest town)

WELL PURPOSE:
(home, irrigation, municipal, industrial)

WELL COMPLETION DATA: 8-15-80

- (1) diameter (inches) 4"
- (2) total depth (feet) 70'
- (3) static water level (feet) 9' below top of ground.
- (4) casing PVC, 60',
(material) (depth)
4"
(size) If telescope see back.
- (5) screen 10', 60'
(length) (depth to top)
4", PVC
(size) (material)
- (6) pump 1/2 11
(HP) (yield gpm)
SE
(type power)
- (7) electric log (yes or no)
(organization running log)

(8) how well bottom plugged 2" PVC
Back wash valve

DRILLERS REMARKS: good


DEPT. OF NATURAL RESOURCES
BUREAU OF LAND & WATER RESOURCES

SEP 20 1980

RECEIVED

If well telescopes please sketch and show depths.

GROUND LEVEL

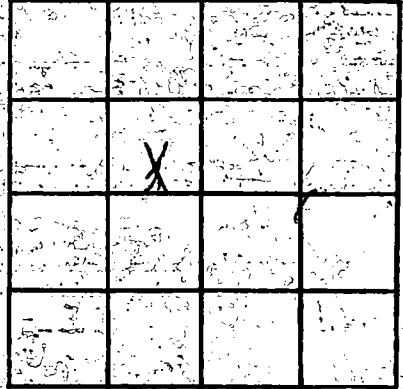

SECTION 8

Please indicate well location X.

ADDITIONAL INFORMATION

If more than one screen, show locations of each on sketch.