


JACKSON  
m 7071

MISSISSIPPI  
BOARD OF WATER COMMISSIONERS  
416 North State Street  
Jackson, Mississippi 39201

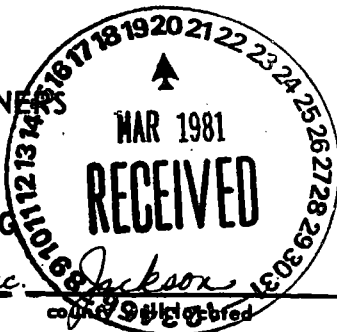

6-30-80

WATER WELL DRILLERS LOG

6-30-80  
date well completed

19 Coast Water Well Service, Inc.  
firm name

LANDOWNER: Frank Vice  
Franks Rd. 9721  
Pascagoula, Miss.  
(mailing address) 39227

description of formations encountered	from	to
Top Soil	0	4
Blue Clay	4	10
White Coarse Sand + Gravel	10	64
Blue Clay	64	187
Gray Coarse Sand	187	225

WELL LOCATION:  
sec 33 T 6 N R 5 W  
3 miles North of Moss Point  
(distance) (direction) (nearest town)

WELL PURPOSE: Home  
(home, irrigation, municipal, industrial)

- WELL COMPLETION DATA:
- (1) diameter (inches) 2"
  - (2) total depth (feet) 225'
  - (3) static water level (feet) 18' <sup>below</sup> above top of ground.
  - (4) casing D.V.C., 215'  
(material) (depth)  
2" (size) If telescope see back.
  - (5) screen 10', 215'  
(length) (depth to top)  
2" (size) p.v.c. (material)
  - (6) pump 1 (HP) 10 (yield gpm)  
(type power)
  - (7) electric log No (yes or no)
  - (8) how well bottom plugged Backwash valve

DRILLERS REMARKS:


DEPT. OF NATURAL RESOURCES  
BUREAU OF LAND & WATER RESOURCES

MAR 20 1981

RECEIVED

If well telescopes please sketch and show depths.

GROUND LEVEL

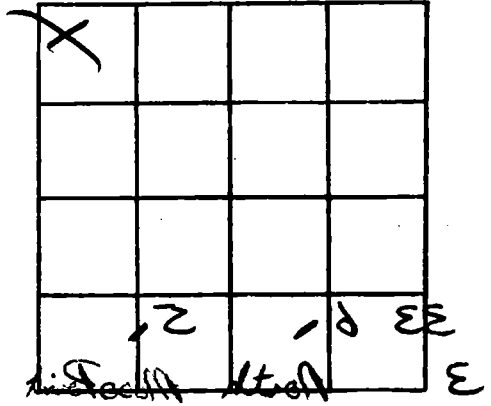

SECTION 33

Please indicate well location X.

ADDITIONAL INFORMATION

01 1

If more than one screen, show locations of each on sketch.