

JACKSON
M 2075
9-5-80
7-5-

MISSISSIPPI
BOARD OF WATER COMMISSIONERS
416 North State Street
Jackson, Mississippi 39201

WATER WELL DRILLERS LOG

date well completed

firm name

county well located

80 Coast Water Well Sewer Jackson

LANDOWNER: Debbie Landford

description of formations encountered

from

to

P.O. Box 1054
Escatawpa, Miss.
(mailing address) 39522

Top soil	0	3
Red clay	3	10
Red coarse sand		
Wood & gravel	10	84
Blue clay	84	137
gray coarse sand	137	187

WELL LOCATION:

sec. 32 T. 6 N R. 5 E
3 miles N of Mass Point
(distance) (direction) (nearest town)

WELL PURPOSE: home
(home, irrigation, municipal, industrial)

WELL COMPLETION DATA:

- (1) diameter (inches) 2"
- (2) total depth (feet) 187'
- (3) static water level (feet) 22 below above top of ground
- (4) casing PVC 177'
(material) (depth)
- 2" If telescope see back.
(size)
- (5) screen 10' 177'
(length) (depth to top)
- 2" PVC
(size) (material)
- (6) pump _____
(HP) (yield gpm)
- (type power) _____
- (7) electric log No.
(yes or no)
- N/A
(organization running log)

(8) how well bottom plugged
Asht Wash Valve

DRILLERS REMARKS:


DEPT. OF NATURAL RESOURCES
BUREAU OF LAND & WATER RESOURCES

APR - 6 1981

RECEIVED

If well telescopes please
sketch and show depths.

GROUND LEVEL

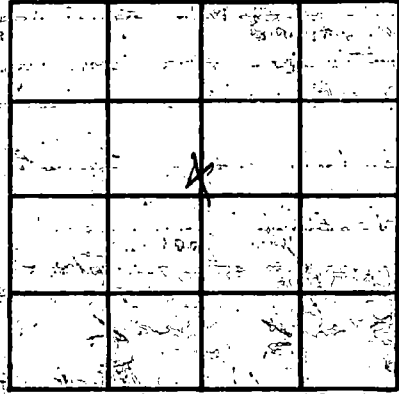

SECTION 32

Please indicate well location X

ADDITIONAL INFORMATION

If more than one screen,
show locations of each on sketch.