

JACKSON
 M 7078
 12-3-79
 Dec 3

MISSISSIPPI
 BOARD OF WATER COMMISSIONERS
 416 North State Street
 Jackson, Mississippi 39201

WATER WELL DRILLERS LOG

Robert Sullivan Co. firm name
Jackson county well located

LANDOWNER: W. G. Blackledge
Helena, Ms. (mailing address)
 WELL LOCATION:
 sec. 28 T. 6 N. R. 5 E
8 miles NE of W.P.
 (distance) (direction) (nearest town)

description of formations encountered	from	to
<u>Sandy clay</u>	<u>0</u>	<u>10</u>
<u>sand</u>	<u>10</u>	<u>80</u>
<u>Clay</u>	<u>80</u>	<u>150</u>
<u>Clay & sand shale</u>	<u>150</u>	<u>245</u>
<u>sand</u>	<u>245</u>	<u>242</u>

WELL PURPOSE: Home
 (home, irrigation, municipal, industrial)


WELL COMPLETION DATA:
 (1) diameter (inches) 2
 (2) total depth (feet) 260
 (3) static water level (feet) 4 below above top of ground.
 (4) casing PVC (material) (depth) _____
 (size) If telescope, see back.
 (5) screen 5' (length) 24 (depth to top)
2" (size) PVC (material)
 (6) pump 1/2 (HP) 10 (yield/gpm)
elec (type power)
 (7) electric log no (yes or no)
 (organization running log) _____
 (8) how well bottom plugged B.P. Valve

DEPT. OF NATURAL RESOURCES BUREAU OF LAND & WATER RESOURCES
JUN 5 - 1981
RECEIVED

DRILLERS REMARKS:

If well telescopes please sketch and show depths.

GROUND LEVEL

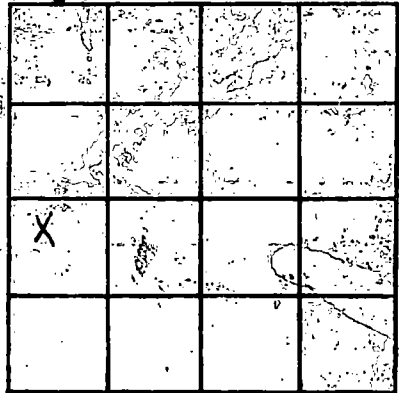

SECTION 28

Please indicate well location X.

ADDITIONAL INFORMATION

If more than one screen, show locations of each on sketch.