

MISSISSIPPI DEPARTMENT OF NATURAL RESOURCES

Bureau of Land and Water Resources

Southport Mall

P.O. Box 10631

Jackson, Mississippi 39209

WATER WELL DRILLERS LOG

Jackson
M 7082
4-10-81
4-10

19 Coast Water Well Sew. Jackson
firm name county well located

LANDOWNER: Catherine Plator
4530 Mill Ave
Missouri, Miss.
(mailing address) JN13

description of formations encountered	from	to
<u>Red Clay</u>	<u>1'</u>	<u>13'</u>
<u>Red coarse sand + gravel</u>	<u>13'</u>	<u>61'</u>
<u>Blue Clay</u>	<u>61'</u>	<u>109'</u>
<u>Blue Clay + streak of sand</u>	<u>104'</u>	<u>130'</u>
<u>Blue Clay</u>	<u>130'</u>	<u>175'</u>
<u>Gray coarse sand</u>	<u>175'</u>	<u>230'</u>

WELL LOCATION:
sec. 35 T. 6 N. R. 5 E.
5 miles NE of MISSISSIPPI
(distance) (direction) (nearest town)

WELL PURPOSE: None
(home, irrigation, municipal, industrial)

WELL COMPLETION DATA:

(1) diameter (inches) 2"

(2) total depth (feet) 230'

(3) static water level (feet) 3' (below/above top of ground)

(4) casing PVC, 220'
(material) (depth)
2"
(size) If telescope see back.

(5) screen 10', 220'
(length) (depth to top)
2", PVC
(size) (material)

(6) pump _____ (HP) _____ (yield gpm)
Electric
(type power)

(7) electric log No.
(yes or no)

(organization running log)

(8) how well bottom plugged Back wash valve

DRILLERS REMARKS:


DEPT. OF NATURAL RESOURCES
BUREAU OF LAND & WATER RESOURCES

JUN 2 - 1981

RECEIVED

If well telescopes please sketch and show depths.

GROUND LEVEL

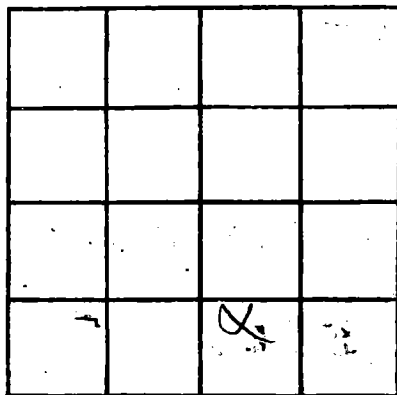

SECTION 35

Please indicate well location X.

ADDITIONAL INFORMATION

If more than one screen, show locations of each on sketch.