

JACKSON
M 2084
4-1-81

MISSISSIPPI
BOARD OF WATER COMMISSIONERS
416 North State Street
Jackson, Mississippi 39201

WATER WELL DRILLERS LOG

4-1-81 date well completed 1981 Pierce Drilling Co. firm name Jackson county well located

LANDOWNER: Delores Biggs


description of formations encountered	from	to
Top Soil	0	10
Clay	10	25
Good Sand	25	65

Wade, Ms
(mailing address)

WELL LOCATION:
sec. 24 T. 6 N. R. 5 E
25 miles South of Lucedale
(distance) (direction) (nearest town)

WELL PURPOSE:
(home) irrigation, municipal, industrial


- WELL COMPLETION DATA:
- diameter (inches) 2"
 - total depth (feet) 65'
 - static water level (feet) 18' below top of ground. above
 - casing Plastic, 60'
(material) (depth)
 - screen 5', 65'
(length) (depth to top)
1/2", Plastic
(size) (material)
 - pump 1 (HP) 12 (yield gpm)
Electric
(type power)
 - electric log (yes or no)
 - how well bottom plugged BW

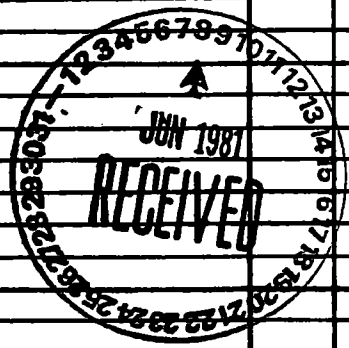

DRILLERS REMARKS:

If well telescopes please sketch and show depths.

GROUND LEVEL

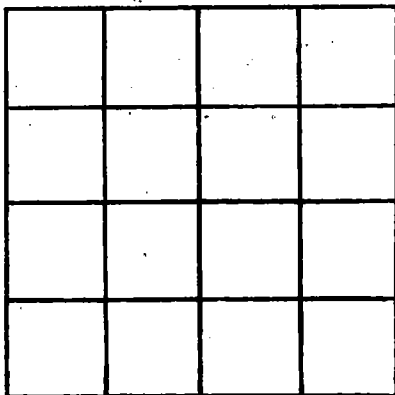

SECTION _____

Please indicate well location X.

ADDITIONAL INFORMATION

If more than one screen, show locations of each on sketch.