

MISSISSIPPI DEPARTMENT OF NATURAL RESOURCES

Bureau of Land and Water Resources

Southport Mall

P.O. Box 10631

Jackson, Mississippi 39209

WATER WELL DRILLERS LOG

JACKSON
M 2086
5-8-81
5-8-81

date well completed

firm name

county well located

Orish Water Well Sew. *Jackson*

LANDOWNER:

description of formations encountered

from

to

Richard Johnson
1410 Constitution
Precedently Miss.
7777 (mailing address) 39267

Top soil
Red clay +
sand and gravel
4' 60'

WELL LOCATION:

sec. *7* T. *6* N. R. *4* E.
10 miles *NE* of *Mass Point*
(distance) (direction) (nearest town)

WELL PURPOSE:


(home, irrigation, municipal, industrial)

WELL COMPLETION DATA:

- (1) diameter (inches) 2"
- (2) total depth (feet) 60'
- (3) static water level (feet) 24' below above
top of ground.
- (4) casing PVC 40'
(material) (depth)
- 2"
(size) if telescope see back.
- (5) screen 10' 40'
(length) (depth to top)
- 2" PVC
(size) (material)
- (6) pump — —
(HP) (yield gpm)
- (type power)
- (7) electric log No.
(yes or no)
- (organization running log)

(8) how well bottom plugged
Back Wash Valve

DRILLERS REMARKS:

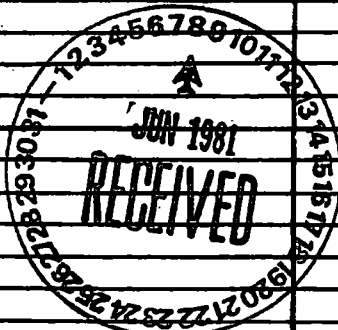

If well telescopes please sketch and show depths.

GROUND LEVEL

			X

SECTION 7

Please indicate well location X:

ADDITIONAL INFORMATION

If more than one screen, show locations of each on sketch.