

MISSISSIPPI DEPARTMENT OF NATURAL RESOURCES

Bureau of Land and Water Resources

Southport Mall

P.O. Box 10631

Jackson, Mississippi 39209

WATER WELL DRILLERS LOG

JACKSON
M 2090
7-28-81

7-28-81 date well completed
Coast Water Well Dr. Jackson firm name
Jackson county well located

LANDOWNER:

Joe Rockwell
Rt 3 Box 33
Pasadena Miss.
(mailing address)

WELL LOCATION:

sec. 32 T 6 N R 5 E
1 N miles (distance) - (direction) of HELENA (nearest town)

WELL PURPOSE:

Home (home, irrigation, municipal, industrial)

WELL COMPLETION DATA:

- (1) diameter (inches) 2"
- (2) total depth (feet) 150'
- (3) static water level (feet) 20' below top of ground.
- (4) casing PVC 140' (material) (depth)
- (5) screen 2" (size) 10' (length) 140' (depth to top)
- (6) pump 1/2 h.p. 7 (material) (yield gpm)
- (7) electric log No. (type power) (yes or no)
- (organization running log)

description of formations encountered

description of formations encountered	from	to
Top soil	0'	10'
Sand	10'	58'
G. Clay	58'	65'
Sand G.	65'	80'
B. Clay	80'	135'
M. Sand	135'	150'

DEPT. OF NATURAL RESOURCES
BUREAU OF LAND & WATER RESOURCES

AUG 14 1981


RECEIVED

DRILLERS REMARKS:

How well bottom plugged?
Backwash valve

If well telescopes please sketch and show depths.

GROUND LEVEL

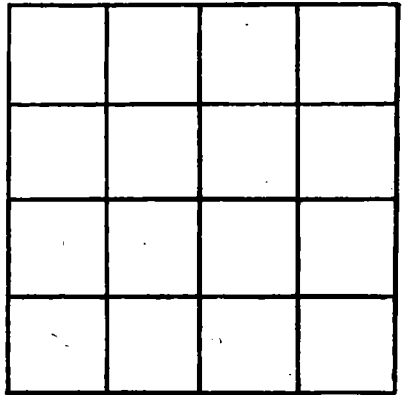

SECTION _____

Please indicate well location X.

ADDITIONAL INFORMATION

If more than one screen, show locations of each on sketch.