

MISSISSIPPI DEPARTMENT OF NATURAL RESOURCES

Bureau of Land and Water Resources

Southport Mall

P.O. Box 10631

Jackson, Mississippi 39209

WATER WELL DRILLERS LOG

M 2092

12-2-81 19 Coast Water Well Sew. Jackson  
 date well completed firm name county well located

LANDOWNER: Jack Thornton  
14808 Timber Ridge Rd.  
Pascagoula, Missi.  
 (mailing address) 39167

WELL LOCATION:  
 sec. 6 T. 6 S. R. 5  
7 miles N of ESCATAWPA  
 (distance) (direction) (nearest town)

WELL PURPOSE: None  
 (home, irrigation, municipal, industrial)

WELL COMPLETION DATA:  
 (1) diameter (inches) 2"  
 (2) total depth (feet) 187'  
 (3) static water level (feet) 21' <sup>below</sup> <sub>above</sub> top of ground.  
 (4) casing PVC 177'  
 (material) (depth)  
2" if telescope see back.  
 (size)  
 (5) screen 10' 177'  
 (length) (depth to top)  
2" PVC  
 (size) (material)  
 (6) pump 1 1/2 HP 10  
 (HP) (yield gpm)  
Electric  
 (type power)  
 (7) electric log No.  
 (yes or no)  
 (organization running log)

description of formations encountered	from	to
<u>Top soil</u>	<u>0</u>	<u>2'</u>
<u>Red Clay</u>	<u>2'</u>	<u>10'</u>
<u>Blue Clay</u>	<u>10'</u>	<u>21'</u>
<u>Red Coarse sand &amp; gravel</u>	<u>21'</u>	<u>64'</u>
<u>Red Coarse sand &amp; gravel</u>	<u>64'</u>	<u>94'</u>
<u>Blue Clay</u>	<u>94'</u>	<u>151'</u>
<u>Grey Coarse sand</u>	<u>151'</u>	<u>187'</u>

DEPT. OF NATURAL RESOURCES  
 BUREAU OF LAND & WATER RESOURCES

JAN 26 1982


RECEIVED

(8) how well bottom plugged Back to back Valve

DRILLERS REMARKS:

If well telescopes please sketch and show depths.

GROUND LEVEL

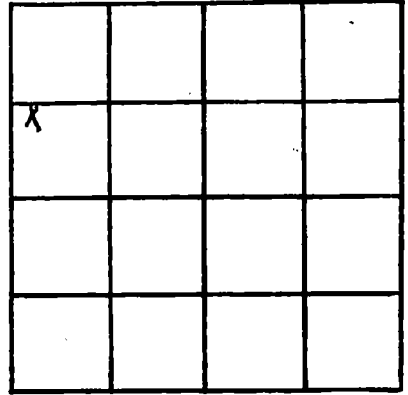

SECTION 6

Please indicate well location X.

ADDITIONAL INFORMATION

If more than one screen, show locations of each on sketch.