

MISSISSIPPI DEPARTMENT OF NATURAL RESOURCES
Bureau of Land and Water Resources
Southport Mall
P.O. Box 10631
Jackson, Mississippi 39209
WATER WELL DRILLERS LOG

M 2093

12-21-81 date well completed
81 Coast Water Well Serv. firm name
Jackson county well located

LANDOWNER Byrne Jinger
12058 Cherry Valley Rd.
Osageola, Miss.
(mailing address) 39567

description of formations encountered	from	to
Top soil	0	18'
R. Clay	18'	40'
C. Sand	40'	68'

WELL LOCATION:
sec. 8 T 6 N R. 5 E
8 miles NE of Miss Point
(distance) (direction) (nearest town)

WELL PURPOSE:
(home, irrigation, municipal, industrial)

WELL COMPLETION DATA:

(1) diameter (inches) 2"
(2) total depth (feet) 68'
(3) static water level (feet) 30' below
top of ground. ground
(4) casing PVC 58'
(material) (depth)
2" If telescope see back.
(size)
(5) screen 10' 58'
(length) (depth to top)
2" PVC
(size) (material)
(6) pump 1/2 hp 5
(HP) (yield gpm)
Electric
(type power)
(7) electric log No.
(yes or no)

(organization running log)

(8) how well bottom plugged/
back wash valve

DRILLERS REMARKS:


DEPT. OF NATURAL RESOURCES
BUREAU OF LAND & WATER RESOURCES

JAN 26 1982

RECEIVED

If well telescopes please sketch and show depths.

GROUND LEVEL

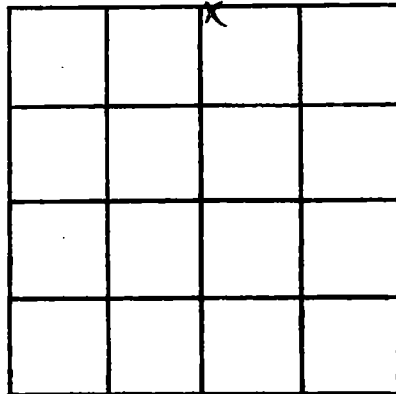

SECTION 8

Please indicate well location X.

ADDITIONAL INFORMATION

If more than one screen, show locations of each on sketch.