

**MISSISSIPPI DEPARTMENT OF NATURAL RESOURCES**  
**Bureau of Land and Water Resources**  
 Southport Mall  
 P.O. Box 10631  
 Jackson, Mississippi 39209  
**WATER WELL DRILLERS LOG**

Jackson  
M 2294

10-29-81 Pierce Drilling Co. Jackson  
 date well completed                      firm name                      county well located


LANDOWNER: <u>Robert Veara</u>	description of formations encountered	from	to
<u>Helena Ms</u> (mailing address)	<u>top soil</u>	<u>0</u>	<u>10</u>
	<u>sand</u>	<u>10</u>	<u>35</u>
	<u>clay</u>	<u>35</u>	<u>125</u>
	<u>good sand</u>	<u>125</u>	<u>160</u>
<b>WELL LOCATION:</b> sec. <u>28 T 6 N</u> R. <u>5 E</u> (distance) miles <u>35</u> <u>South</u> of <u>Huckle</u> (direction) (nearest town)			
<b>WELL PURPOSE:</b> ( <u>home</u> , Irrigation, municipal, industrial)			
<b>WELL COMPLETION DATA:</b>			
(1) diameter (inches) <u>2"</u>			
(2) total depth (feet) <u>160'</u>			
(3) static water level (feet) <u>60</u> <u>below</u> top of ground.			
(4) casing <u>Plastic</u> , <u>150'</u> (material) (depth)			
<u>0</u> if telescope see back. (size)			
(5) screen <u>10'</u> , <u>160'</u> (length) (depth to top)			
<u>20x</u> , <u>Plastic</u> (size) (material)			
(6) pump <u>1</u> (HP) <u>8</u> (yield gpm)			
<u>Electric</u> (type power)			
(7) electric log (yes or no) <u>          </u>			
(organization running log) <u>          </u>			
(8) how well bottom plugged <u>BW</u>			

DRILLERS REMARKS:           

DEPT. OF NATURAL RESOURCES  
 BUREAU OF LAND & WATER RESOURCES  
 MAR 11 1982  
**RECEIVED**

If well telescopes please sketch and show depths.

GROUND LEVEL

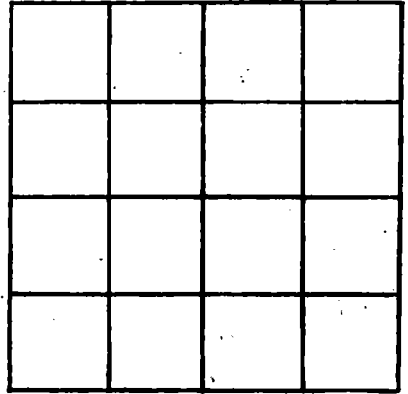

SECTION \_\_\_\_\_

Please indicate well location X.

ADDITIONAL INFORMATION

If more than one screen, show locations of each on sketch.