

MISSISSIPPI DEPARTMENT OF NATURAL RESOURCES

Bureau of Land and Water Resources

Southport Mall

P.O. Box 10631

Jackson, Mississippi 39209

WATER WELL DRILLERS LOG

Jackson
M 2097

3-19-82 1982 Coas & Water Well Sew. Jackson
date well completed firm name county well located

LANDOWNER: Jackson County, Dist. II
P.O. Drawer 1520
Escatawpa, Miss.
(mailing address) 38552

description of formations encountered	from	to
Sandy Top Soil	0	10'
Red Clay	10'	30'
Coarse Sand	30'	150'
Blue Clay	57'	150'
M. sand	150'	167'

WELL LOCATION:
sec. 32 T. 6 S. R. 5 E.
1/4 miles (distance) of HELENA (nearest town)
(direction)

WELL PURPOSE: Home
(home, irrigation, municipal, industrial)

WELL COMPLETION DATA:
(1) diameter (inches) 2"
(2) total depth (feet) 167'
(3) static water level (feet) 40' below top of ground.
(4) casing PVC, 157' (material), (depth)
2" (size) If telescope see back.
(5) screen 10', 157' (length), (depth to top)
2" (size), PVC (material)
(6) pump 1 hp. - 8 - (HP), (yield gpm)
Elect. (type power)
(7) electric log No. (yes or no)

(8) how well bottom plugged: Jack Wash Valve.

DRILLERS REMARKS:


DEPT. OF NATURAL RESOURCES
BUREAU OF LAND & WATER RESOURCES

APR 12 1982

DEPT. OF NATURAL RESOURCES

If well telescopes please sketch and show depths.

GROUND LEVEL

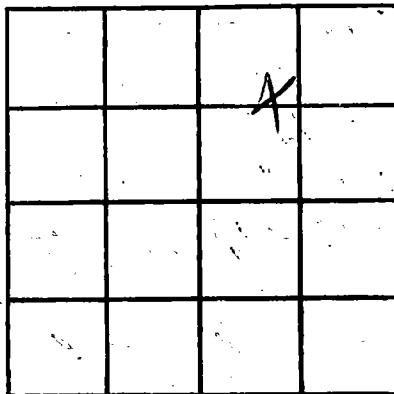

SECTION 32

Please indicate well location X.

ADDITIONAL INFORMATION

If more than one screen, show locations of each on sketch.