

MISSISSIPPI DEPARTMENT OF NATURAL RESOURCES

Bureau of Land and Water Resources

Southport Mall

P.O. Box 10631

Jackson, Mississippi 39209

WATER WELL DRILLERS LOG

Jackson
M 2099

4-6-82 19 Coast Water Well Sew. Jackson
date well completed firm name county well located

LANDOWNER: Paul Blackledge description of formations encountered from to

7400 Nut Bank Rd.
Passapatanz miss
(mailing address)

description of formations encountered	from	to
<u>Top soil</u>	<u>0</u>	<u>5'</u>
<u>Red coarse sand</u>	<u>5'</u>	<u>21'</u>
<u>Red coarse sand & gravel</u>	<u>21'</u>	<u>45'</u>
<u>Red Clay</u>	<u>45'</u>	<u>54'</u>
<u>Blue Clay</u>	<u>54'</u>	<u>63'</u>
<u>White coarse sand</u>	<u>63'</u>	<u>103'</u>

WELL LOCATION:
sec. 9 T 6 N R 5 E
4 miles S of POINT
(distance) (direction) (nearest town)

WELL PURPOSE: Home
(home, irrigation, municipal, industrial)

WELL COMPLETION DATA:

- (1) diameter (inches) 2"
- (2) total depth (feet) 103'
- (3) static water level (feet) 13' below top of ground.
- (4) casing PVC 93'
(material) (depth)
- 2"
(size) If telescope see back.
- (5) screen 10' 93'
(length) (depth to top)
- 2" PVC
(size) (material)
- (6) pump — —
(HP) (yield gpm)
- (type power) —
- (7) electric log No.
(yes or no)
- (organization running log) —

(8) How well bottom plugged: Back wash water

DRILLERS REMARKS: —


DEPT. OF NATURAL RESOURCES
BUREAU OF LAND & WATER RESOURCES

MAY 10 1982

RECEIVED

If well telescopes please sketch and show depths.

GROUND LEVEL

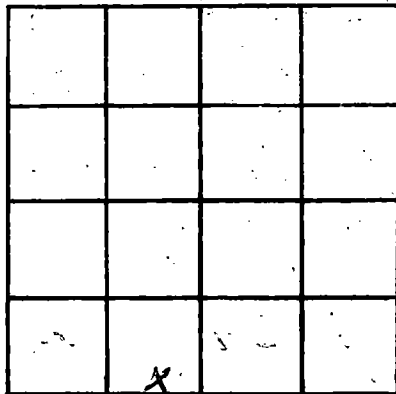

SECTION 9

Please indicate well location X.

ADDITIONAL INFORMATION

If more than one screen, show locations of each on sketch.