

MISSISSIPPI DEPARTMENT OF NATURAL RESOURCES

Bureau of Land and Water Resources

Southport Mall

P.O. Box 10631

Jackson, Mississippi 39209

WATER WELL DRILLERS LOG

Jackson  
M2101

6-10 1982 Pierce Drilling Co. Jackson  
date well completed firm name county well located

LANDOWNER: Jerry Walker  
Rt 2

description of formations encountered	depth	
	from	to
<u>Top Soil</u>	<u>0</u>	<u>15</u>
<u>Good Sand</u>	<u>15</u>	<u>75</u>
<u>Clay</u>	<u>75</u>	<u>130</u>
<u>Good Sand</u>	<u>130</u>	<u>150</u>

Pascagoula Ms  
(mailing address)

WELL LOCATION:

sec 30 T 6 N R 5 E  
7 miles South of Big Point  
(distance) (direction) (nearest town)

WELL PURPOSE:

(home) irrigation, municipal, industrial

WELL COMPLETION DATA:

- (1) diameter (inches) 2"
- (2) total depth (feet) 150'
- (3) static water level (feet) 30 below above top of ground.
- (4) casing Plastic, 140'  
(material) (depth)
- 0 if telescope see back.  
(size)
- (5) screen 10', 150'  
(length) (depth to top)
- 008, Plastic  
(size) (material)
- (6) pump 1 12  
(HP) (yield gpm)
- Electric  
(type power)
- (7) electric log (yes or no)
- (organization running log)
- (8) how well bottom plugged BW

DEPT. OF NATURAL RESOURCES  
BUREAU OF LAND & WATER RESOURCES


JUL 14 1982

RECEIVED

DRILLERS REMARKS:

If well telescopes please sketch and show depths.

GROUND LEVEL

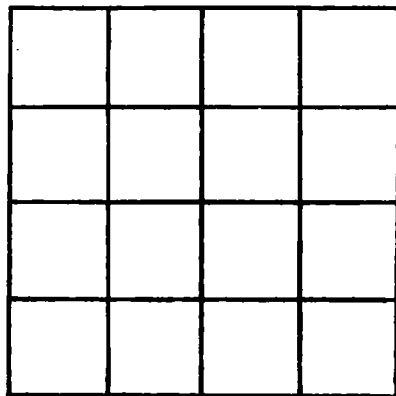

SECTION \_\_\_\_\_

Please indicate well location X.

ADDITIONAL INFORMATION

If more than one screen, show locations of each on sketch.