

MISSISSIPPI DEPARTMENT OF NATURAL RESOURCES

Bureau of Land and Water Resources

Southport Mall

P.O. Box 10631

Jackson, Mississippi 39209

WATER WELL DRILLERS LOG

Jackson
M 2103

10-22-82 19 Coast Water Well Serv. Jackson
date well completed firm name county well located

LANDOWNER Sathy Wiggins

Box 3, Box 22

description of formations encountered

from

to

Pascagoula Miss.
(mailing address) 37567

Top soil

0 5'

WELL LOCATION:

sec. 8 T. 6 N. R. 5 E
4 miles SSW of BIG POINT
(distance) (direction) (nearest town)

R. Clay

5' 35'

C. Sand & G.

35' 123'

S. Clay

123' 175'

C. Sand

175' 185'

WELL PURPOSE: Home
(home, irrigation, municipal, industrial)

WELL COMPLETION DATA:

(1) diameter (inches) 2"
(2) total depth (feet) 185'
(3) static water level (feet) 16' below
top of ground. above

(4) casing PVC, 175'
(material) (depth)

2"
(size) if telescope see back.

(5) screen 10', 175'
(length) (depth to top)

2", PVC
(size) (material)

(6) pump 1/2 h.p., 7-
(HP) (yield gpm)

Elect.
(type power)

(7) electric log No.
(yes or no)

(organization running log)

(8) How well bottom plugged
back wash valve

DEPT. OF NATURAL RESOURCES
BUREAU OF LAND & WATER RESOURCES


NOV 18 1982

RECEIVED

DRILLERS REMARKS:

If well telescopes please sketch and show depths.

GROUND LEVEL

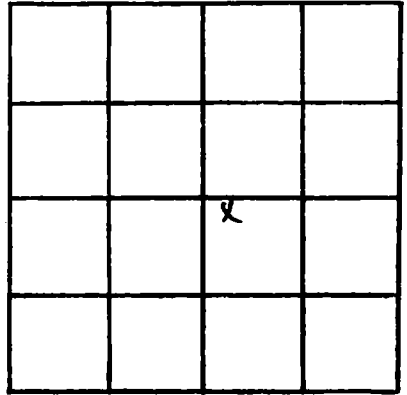

SECTION 8

Please indicate well location X.

ADDITIONAL INFORMATION

A series of horizontal lines for writing additional information, starting below the 'ADDITIONAL INFORMATION' header and extending to the bottom of the page.

If more than one screen, show locations of each on sketch.