

Jackson
M 9164

MISSISSIPPI DEPARTMENT OF NATURAL RESOURCES
Bureau of Land and Water Resources
Southport Mall
P.O. Box 10631
Jackson, Mississippi 39209
WATER WELL DRILLERS LOG

1-18 1983 Pierce Drilling Co. Jackson
date well completed firm name county well located

LANDOWNER: Julian Henderson

description of formations encountered

from

to

Hurley, Ms
(mailing address)

Top Soil

0 10

Sand & Clay

10 25

Good Sand

25 45

WELL LOCATION:

sec. 2 T 6 N R 5 E
5 miles West of Big Point
(distance) (direction) (nearest town)

WELL PURPOSE:

(home, irrigation, municipal, industrial)

WELL COMPLETION DATA:

- (1) diameter (inches) 2"
- (2) total depth (feet) 45'
- (3) static water level (feet) 25' ^{below} above top of ground.
- (4) casing Plastic, 40'
(material) (depth)
0 (size) if telescope see back.
- (5) screen 5' 45'
(length) (depth to top)
00%, Plastic
(size) (material)
- (6) pump 1 10
(HP) (yield gpm)
Electric
(type power)
- (7) electric log (yes or no)
- (organization running log)
- (8) how well bottom plugged BW

DEPT. OF NATURAL RESOURCES
BUREAU OF LAND & WATER RESOURCES


MAY 24 1983

RECEIVED

DRILLERS REMARKS:

If well telescopes please sketch and show depths.

GROUND LEVEL

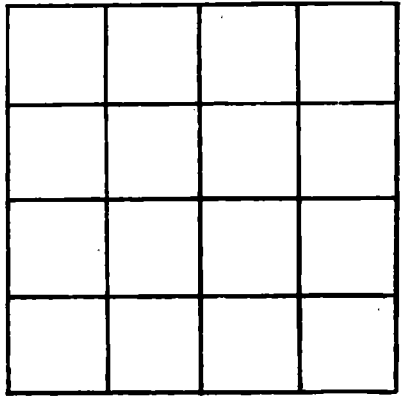

SECTION _____

Please indicate well location X.

ADDITIONAL INFORMATION

A series of horizontal lines for recording additional information, starting below the 'ADDITIONAL INFORMATION' header and extending to the bottom of the page.

If more than one screen, show locations of each on sketch.