

Jackson  
M2105

MISSISSIPPI DEPARTMENT OF NATURAL RESOURCES  
Bureau of Land and Water Resources  
Southport Mall  
P.O. Box 10631  
Jackson, Mississippi 39209  
WATER WELL DRILLERS LOG

3-28, 1983 date well completed  
Poree Drilling Co firm name  
Jackson county well located

LANDOWNER: Gilbert Baughman  
8526 Prim Rose Lane  
Passagonala, MS  
(mailing address)

description of formations encountered	depth	
	from	to
Top Soil	0	10
Sand & Clay	10	30
Good Sand	30	65
Clay	65	175
Good Sand	175	198

WELL LOCATION:  
sec. 26 T. 6 N. R. 5 E  
4 miles East of Helena  
(distance) (direction) (nearest town)

WELL PURPOSE:  
(home, irrigation, municipal, industrial)

WELL COMPLETION DATA:  
(1) diameter (inches) 2"  
(2) total depth (feet) 198'  
(3) static water level (feet) 20' below top of ground.  
(4) casing Plastic, 188'  
(material) (depth)  
0 (size) If telescope see back.  
(5) screen 10', 198'  
(length) (depth to top)  
006, Plastic  
(size) (material)  
(6) pump 1 (HP), 10 (yield gpm)  
Electric  
(type power)  
(7) electric log (yes or no)  
(organization running log)  
(8) how well bottom plugged BW

DRILLERS REMARKS:


DEPT. OF NATURAL RESOURCES  
BUREAU OF LAND & WATER RESOURCES

MAY 24 1983

RECEIVED

If well telescopes please sketch and show depths.

GROUND LEVEL

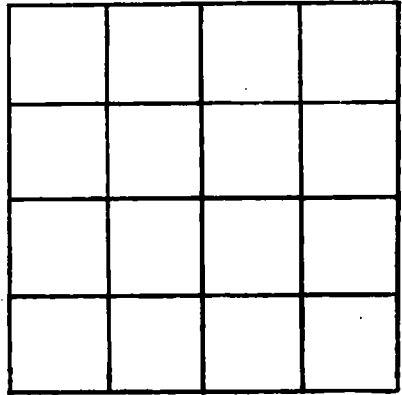

SECTION \_\_\_\_\_

Please indicate well location X.

ADDITIONAL INFORMATION

If more than one screen, show locations of each on sketch.