

Jackson
M 2108

MISSISSIPPI DEPARTMENT OF NATURAL RESOURCES
Bureau of Land and Water Resources
Southport Mall
P.O. Box 10631
Jackson, Mississippi 39209
WATER WELL DRILLERS LOG

4-15-83 19 Cross Water Well Sew. Jackson
date well completed firm name county well located

LANDOWNER: Gene Bakley
6400 Hands Road
Pascagoula Miss.
(mailing address)

WELL LOCATION:
sec. 29 T. 6 S. R. 5 W.
1N miles of HELENA
(distance) (direction) (nearest town)

WELL PURPOSE: Home
(home, irrigation, municipal, industrial)

WELL COMPLETION DATA:
(1) diameter (inches) 2"
(2) total depth (feet) 199'
(3) static water level (feet) 13' below
top of ground. surface
(4) casing PVC, 189'
(material) (depth)
2"
(size) If telescope see back.
(5) screen 10', 189'
(length) (depth to top)
2", PVC
(size) (material)
(6) pump _____
(HP) (yield gpm)
Sub
(type power)
(7) electric log No.
(yes or no)

(organization running log)

description of formations encountered	from	to
Top soil	0	3'
Red Clay	3'	10'
Blue Clay	10'	15'
White coarse sand	-	-
gravel & wood	15'	70'
Blue Clay	70'	110'
Blue Clay & Sand	-	-
of sand	110'	150'
Gray coarse sand	150'	199'

DEPT. OF NATURAL RESOURCES
BUREAU OF LAND & WATER RESOURCES

JUN 24 1983


RECEIVED

(8) how well bottom plugged Back wash valve

DRILLERS REMARKS:

If well telescopes please sketch and show depths.

GROUND LEVEL

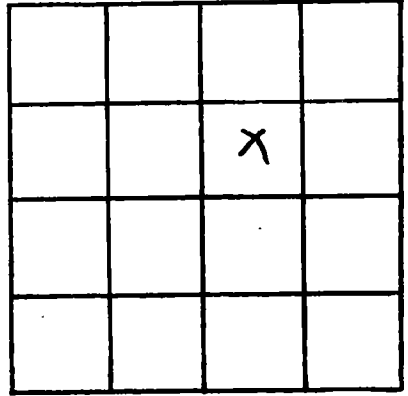

SECTION 29

Please indicate well location X.

ADDITIONAL INFORMATION

If more than one screen, show locations of each on sketch.