

MISSISSIPPI DEPARTMENT OF NATURAL RESOURCES

Bureau of Land and Water Resources

Southport Mall

P.O. Box 10631

Jackson, Mississippi 39209

WATER WELL DRILLERS LOG

Jackson
M2113

9-6-83
date well completed

Coast Water Well Sew. Jackson
firm name county well located

LANDOWNER: James Davis
12833 Saracenia Rd.
Pascagoula, Miss.
(mailing address) 39567

| description of formations encountered | from | to |
|---------------------------------------|------|------|
| Top soil | 0 | 2' |
| Red Clay | 2' | 15' |
| Blue Clay | 15' | 30' |
| White Coarse sand | 30' | 45' |
| Blue Clay & streak of sand | - | - |
| Red Coarse sand & gravel | 45' | 60' |
| Blue Clay | 60' | 150' |
| Gray Coarse sand | 150' | 190' |
| | 190' | 220' |

WELL LOCATION:
sec. 17 T-6 S R. 5 W
2 miles N of HELENA
(distance) (direction) (nearest town)

WELL PURPOSE: home
(home, irrigation, municipal, industrial)

- WELL COMPLETION DATA:
- (1) diameter (inches) 2"
 - (2) total depth (feet) 220'
 - (3) static water level (feet) 63 below top of ground
 - (4) casing PVC 210'
(material) (depth)
2" If telescope see back.
(size)
 - (5) screen 10' 210'
(length) (depth to top)
2" PVC
(size) (material)
 - (6) pump 1 hp. 8
(HP) (yield gpm)
Elect.
(type power)
 - (7) electric log No.
(yes or no)
(organization running log)
 - (8) back work value
how well bottom plugged

DRILLERS REMARKS:


DEPT. OF NATURAL RESOURCES
BUREAU OF LAND & WATER RESOURCES

OCT 14 1983

RECEIVED

If well telescopes please sketch and show depths.

GROUND LEVEL

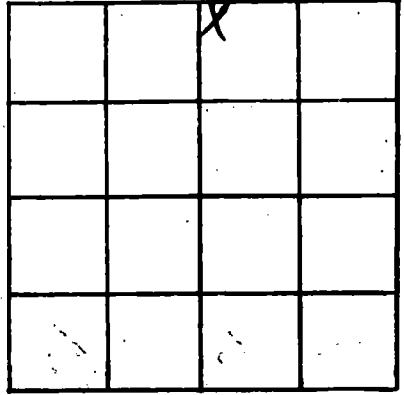

SECTION 17

Please indicate well location X.

ADDITIONAL INFORMATION

If more than one screen, show locations of each on sketch.