

**MISSISSIPPI DEPARTMENT OF NATURAL RESOURCES**  
**Bureau of Land and Water Resources**  
 Southport Mall  
 P.O. Box 10631  
 Jackson, Mississippi 39209  
**WATER WELL DRILLERS LOG**

Jackson  
MAH

3-19-84 Pierce Drilling Co. Jackson  
 date well completed firm name county well located

LANDOWNER: George Oyche  
3701 Sheffield Rd.  
Pascagoula, Ms.  
 (mailing address)

description of formations encountered	from	to
<u>top soil</u>	<u>0</u>	<u>10</u>
<u>Sand + Clay</u>	<u>10</u>	<u>25</u>
<u>Clay</u>	<u>25</u>	<u>45</u>
<u>Good Sand</u>	<u>45</u>	<u>65</u>

WELL LOCATION:  
 sec. 16 T. 6 N. R. 5 E.  
 (distance) (direction) (nearest town)  
6 miles South of Hurley

WELL PURPOSE:  
 Home,  Irrigation,  municipal,  industrial

**WELL COMPLETION DATA:**

- diameter (inches) 2"
- total depth (feet) 65'
- static water level (feet) 30  below  above top of ground.
- casing plastic, 60  
 (material) (depth)  
0 if telescope see back.  
 (size)
- screen 5', 65'  
 (length) (depth to top)  
poly, plastic  
 (size) (material)
- pump 1 12  
 (HP) (yield gpm)  
electric  
 (type power)
- electric log (yes or no)  
 (organization running log)
- how well bottom plugged BW


DRILLERS REMARKS:

DEPT. OF NATURAL RESOURCES  
 BUREAU OF LAND & WATER RESOURCES

**JUN - 6 1984**  
**RECEIVED**

If well telescopes please sketch and show depths.

GROUND LEVEL

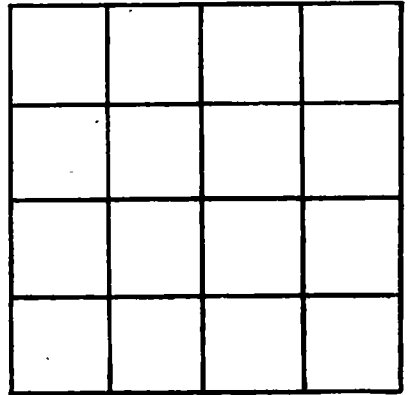

SECTION \_\_\_\_\_

Please indicate well location X.

ADDITIONAL INFORMATION

If more than one screen, show locations of each on sketch.