

MISSISSIPPI DEPARTMENT OF NATURAL RESOURCES

Bureau of Land and Water Resources

Southport Mall

P.O. Box 10631

Jackson, Mississippi 39209

WATER WELL DRILLERS LOG

JACKSON
M 2119

6-13-1984 date well completed
84 Coast Water Well Sew. firm name
Jackson county well located

LANDOWNER: James Magee
14416 Hwy 613
Passapatanz Miss.
(mailing address) 32567

WELL LOCATION:
sec. 4 T-6 R-5
3 miles SW of Big Point
(distance) (direction) (nearest town)

WELL PURPOSE: Home
(home, irrigation, municipal, industrial)

- WELL COMPLETION DATA:
- (1) diameter (inches) 2"
 - (2) total depth (feet) 155'
 - (3) static water level (feet) 18' below top of ground
 - (4) casing PVC 145' (material) (depth)
2" (size) if telescope see back.
 - (5) screen 10' 145' (length) (depth to top)
2" PVC (size) (material)
 - (6) pump 1/2 HP 13 (HP) (yield gpm)
Elect. (type power)
 - (7) electric log No. (yes or no)
 - (organization running log)
 - (8) has well bottom plugged Back Wash Valve

| description of formations encountered | from | to |
|---------------------------------------|------|------|
| Top soil | 0 | 2' |
| Clay | 2' | 6' |
| White sand & pea gravel | 6' | 100' |
| Blue Clay | 100' | 128' |
| White sand | 128' | 155' |
| 3ft Tail Pipe | | |

DEPT. OF NATURAL RESOURCES
BUREAU OF LAND & WATER RESOURCES


JUL 10 1984

RECEIVED

DRILLERS REMARKS:

If well telescopes please sketch and show depths.

GROUND LEVEL

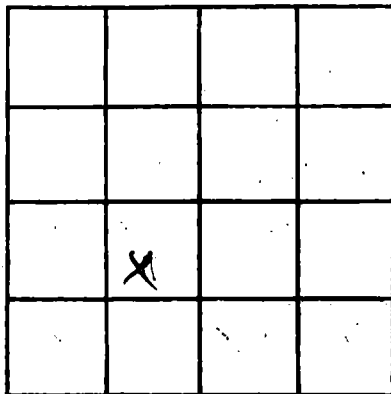

SECTION 4

Please indicate well location X.

ADDITIONAL INFORMATION

If more than one screen, show locations of each on sketch.