

MISSISSIPPI DEPARTMENT OF NATURAL RESOURCES

Bureau of Land and Water Resources

Southport Mall

P.O. Box 10631

Jackson, Mississippi 39209

WATER WELL DRILLERS LOG

Jackson  
M 2122

6-15-84 19 Coast Water Well Sew. Jackson  
date well completed firm name county well located

LANDOWNER: Russell Johnson  
10008 Shindridge dr  
Pascagoula Miss.  
(mailing address) 39567

description of formations encountered	from	to
<u>Top soil</u>	<u>0</u>	<u>2'</u>
<u>Red Clay</u>	<u>2</u>	<u>11'</u>
<u>Red Coarse sand</u>		
<u>Wood &amp; gravel</u>	<u>11'</u>	<u>87'</u>
<u>Blue Clay</u>	<u>87'</u>	<u>106'</u>
<u>Gray Coarse sand</u>	<u>106'</u>	<u>139'</u>
<u>Blue Clay</u>	<u>139'</u>	<u>149'</u>

WELL LOCATION:  
sec 29 T 6 N R 5  
IN miles \_\_\_\_\_ of HELENA  
(distance) (direction) (nearest town)

WELL PURPOSE: Home  
(home, irrigation, municipal, industrial)

WELL COMPLETION DATA:

(1) diameter (inches) 2"

(2) total depth (feet) 149'

(3) static water level (feet) 15' below top of ground. above

(4) casing PVC, 139'  
(material) (depth)

2"  
(size) If telescope see back.

(5) screen 10', 139'  
(length) (depth to top)

24, PVC  
(size) (material)

(6) pump \_\_\_\_\_  
(HP) (yield gpm)

\_\_\_\_\_  
(type power)

(7) electric log No.  
(yes or no)

\_\_\_\_\_  
(organization running log)

(8) how well bottom plugged Back Wash Valve


DRILLERS REMARKS:

DEPT. OF NATURAL RESOURCES  
BUREAU OF LAND & WATER RESOURCES

OCT 11 1984  
RECEIVED

If well telescopes please  
sketch and show depths.

GROUND LEVEL

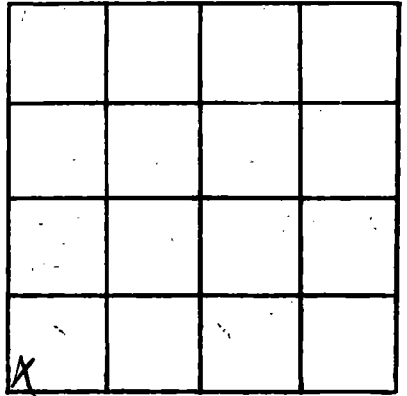

SECTION 29

Please indicate well location X.

**ADDITIONAL INFORMATION**

A series of horizontal lines providing space for additional information.

---

---

If more than one screen,  
show locations of each on sketch.