

MISSISSIPPI DEPARTMENT OF NATURAL RESOURCES

Bureau of Land and Water Resources

Southport Mall

P.O. Box 10631

Jackson, Mississippi 39209

WATER WELL DRILLERS LOG

Jackson  
M 2123

7-18-84 19 Cross Water Well Sew. Jackson  
date well completed firm name county well located

LANDOWNER Helena Ace Hardware

P.O. Box 1027  
Cascataway, Miss.  
(mailing address) 39552

WELL LOCATION:  
sec 29 T 6N R 5E  
IN miles (distance) \_\_\_\_\_ (direction) of HELENA (nearest town)

WELL PURPOSE:  
(home, irrigation, municipal, industrial)

WELL COMPLETION DATA:

- (1) diameter (inches) 2"
- (2) total depth (feet) 280'
- (3) static water level (feet) 20' (below/above top of ground)
- (4) casing PVC, 270' (material) (depth)  
2" (size) if telescope see back.
- (5) screen 10', 270' (length) (depth to top)  
2" (size) PVC (material)
- (6) pump 1/2 hp., 6 1/2 (HP) (yield gpm)  
Electric (type power)
- (7) electric log \_\_\_\_\_ (yes or no)  
\_\_\_\_\_ (organization running log)

(8) how well bottom plugged Back Wash Valve

DRILLERS REMARKS:

Description of formations encountered	from	to
<u>Gray Clay</u>	<u>0</u>	<u>8'</u>
<u>Coarse sand</u>	<u>8</u>	<u>60'</u>
<u>Blue Clay</u>	<u>60'</u>	<u>80'</u>
<u>Gray Clay</u>	<u>80'</u>	<u>117'</u>
<u>Coarse sand</u>	<u>117'</u>	<u>190'</u>
<u>Blue Clay</u>	<u>190'</u>	<u>240'</u>
<u>Coarse sand</u>	<u>240'</u>	<u>280'</u>
<u>Includes 10 x 2 Tail Pipe</u>		


DEPT. OF NATURAL RESOURCES  
BUREAU OF LAND & WATER RESOURCES

OCT 11 1984

**RECEIVED**

If well telescopes please sketch and show depths.

GROUND LEVEL

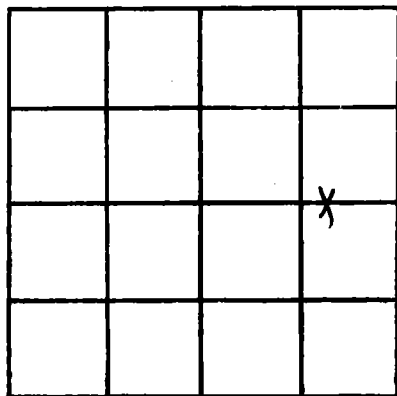

SECTION 27

Please indicate well location X.

ADDITIONAL INFORMATION

If more than one screen, show locations of each on sketch.