

MISSISSIPPI DEPARTMENT OF NATURAL RESOURCES
Bureau of Land and Water Resources
 Southport Mall
 P.O. Box 10631
 Jackson, Mississippi 39209
WATER WELL DRILLERS LOG

Jackson
M2124


9-21-84 date well completed Coast Water Well Sew. firm name Jackson county well located

LANDOWNER: <u>Harley Busby</u>	description of formations encountered	from	to
<u>6600 Hans Road</u>	<u>Top soil</u>	<u>0</u>	<u>15'</u>
<u>Passion only mess.</u> (mailing address) <u>31567</u>	<u>Coarse sand</u>	<u>15'</u>	<u>63'</u>
WELL LOCATION:			
sec <u>29 T 6 N</u> R <u>5 E</u> <u>IN</u> miles _____ of <u>Helena</u> (distance) (direction) (nearest town)			
WELL PURPOSE: <u>Home</u>			
(home, irrigation, municipal, industrial)			
WELL COMPLETION DATA:			
(1) diameter (inches) <u>2"</u>			
(2) total depth (feet) <u>63'</u>			
(3) static water level (feet) <u>10'</u> <u>below</u> top of ground.			
(4) casing <u>PVC</u> <u>53'</u> (material) (depth)			
<u>2"</u> if telescope see back. (size)			
(5) screen <u>10'</u> <u>53'</u> (length) (depth to top)			
<u>2"</u> <u>PVC</u> (size) (material)			
(6) pump _____ (HP) (yield gpm)			
(type power)			
(7) electric log <u>No</u> (yes or no)			
(organization running log)			
(8) <u>How well bottom plugged</u> <u>back wash Helena</u>			
DRILLERS REMARKS:			

DEPT. OF NATURAL RESOURCES
 BUREAU OF LAND & WATER RESOURCE
OCT 12 1984
RECEIVED

If well telescopes please sketch and show depths.

GROUND LEVEL

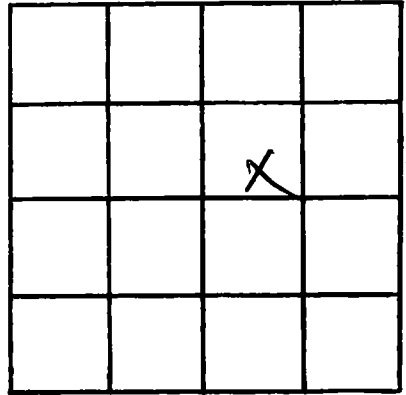

SECTION 29

Please indicate well location X.

ADDITIONAL INFORMATION

If more than one screen, show locations of each on sketch.