

MISSISSIPPI DEPARTMENT OF NATURAL RESOURCES
Bureau of Land and Water Resources
 Southport Mall
 P.O. Box 10631
 Jackson, Mississippi 39209
WATER WELL DRILLERS LOG

Jackson
M 2126

9-16-84 19 *Truppole Well Serv.* *JACKSON*
 date well completed firm name county well located

LANDOWNER: *AL & Kaye*
P.O. Box 537
Vandrew MS. 39564
 (mailing address)

description of formations encountered	from	to
<i>top Soil</i>	<i>0</i>	<i>10</i>
<i>Sand</i>	<i>10</i>	<i>20</i>
<i>Sand</i>	<i>20</i>	<i>30</i>
<i>Clay</i>	<i>30</i>	<i>50</i>
<i>good sand</i>	<i>50</i>	<i>130</i>
<i>Hard clay</i>	<i>130</i>	<i>260</i>
<i>good gravel</i>	<i>260</i>	<i>300</i>

WELL LOCATION:

sec. *3* T. *6* N. R. *5* E
2 miles *S* of *Helesh*
 (distance) (direction) (nearest town)

WELL PURPOSE:

(home) irrigation, municipal, industrial

WELL COMPLETION DATA:

- (1) diameter (inches) *4"*
- (2) total depth (feet) *300'*
- (3) static water level (feet) *88* below above top of ground.
- (4) casing *PVC*, *290*,
 (material) (depth)

4000 If telescope see back.
Delze

- (5) screen *10 #8*, *290'*
 (length) (depth to top)
- 2"* *PVC*
 (size) (material)

- (6) pump *3/4*, *25-20*
 (HP) (yield gpm)
- Elect Sub*
 (type power)

- (7) electric log *no*
 (yes or no)

no
 (organization running log)

- (8) how well bottom plugged *Ball*



DRILLERS REMARKS: *We Only drilled 100'-4" - So we used a Suet Seal on top of Pump. When Water didn't Com back But 12'*

DEPT. OF NATURAL RESOURCES
 BUREAU OF LAND & WATER RESOURCES

DEC 13 1984

RECEIVED

If well telescopes please sketch and show depths.

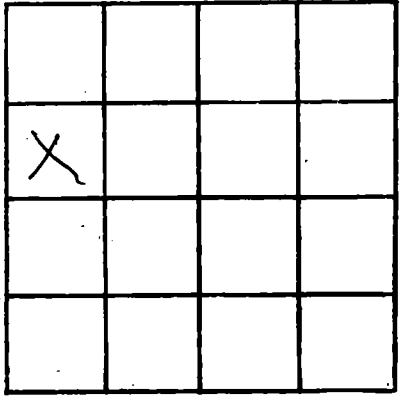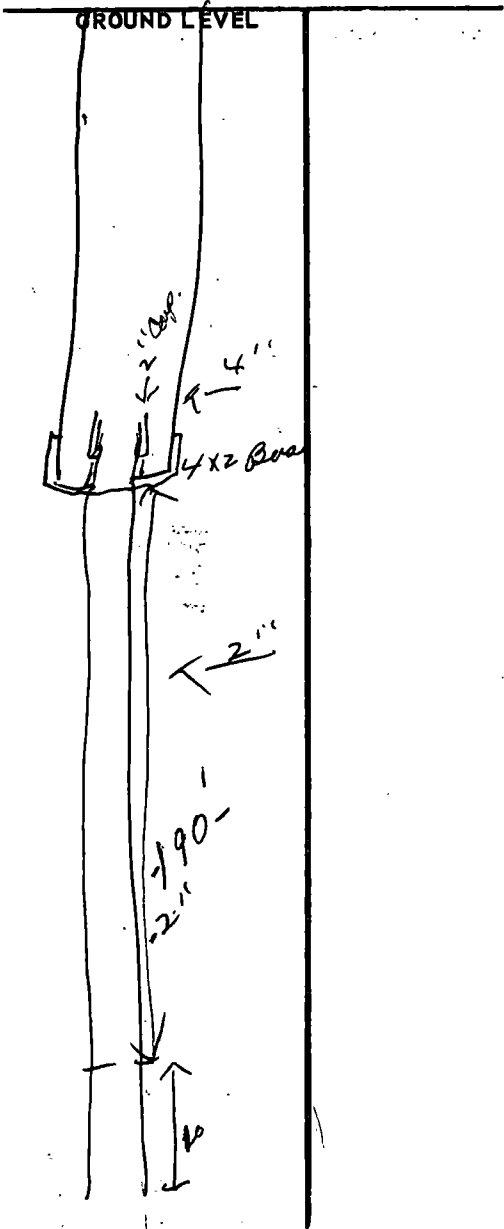

SECTION 23

Please indicate well location X.

ADDITIONAL INFORMATION

If more than one screen, show locations of each on sketch.