

MISSISSIPPI DEPARTMENT OF NATURAL RESOURCES

Bureau of Land and Water Resources

Southport Mall

P.O. Box 10631

Jackson, Mississippi 39209

WATER WELL DRILLERS LOG

Jackson
M2127

10-18-84 19

Coast Water Well Sew.

Jackson

date well completed

firm name

county well located

LANDOWNER:

Harlie Coon

description of formations encountered

from

to

9208 Lotus St.

Red Clay

0 15'

Pascagoula, Miss.

White sand

15' 59'

(mailing address) 37567

WELL LOCATION:

sec 34 T. 6 N. R. 5 W.

Blue Clay

59' 119'

4 miles NE of ESCATAWIPA
(distance) (direction) (nearest town)

White sand

119' 172'

WELL PURPOSE: Home
(home, irrigation, municipal, industrial)

10'-2" PVC Screen

WELL COMPLETION DATA:

- (1) diameter (Inches) 2"
- (2) total depth (feet) 172'
- (3) static water level (feet) 10' below top of ground above
- (4) casing PVC, 162'
(material) (depth)
- 2"
(size) If telescope see back.
- (5) screen 10', 162'
(length) (depth to top)
- 2", PVC
(size) (material)
- (6) pump — (HP) — (yield gpm)
- Elect.
(type power)
- (7) electric log No
(yes or no)
- (organization running log)


(8) How well bottom plugged Back wash valve

DRILLERS REMARKS:

1-8-85
Z & W

If well telescopes please sketch and show depths.

GROUND LEVEL

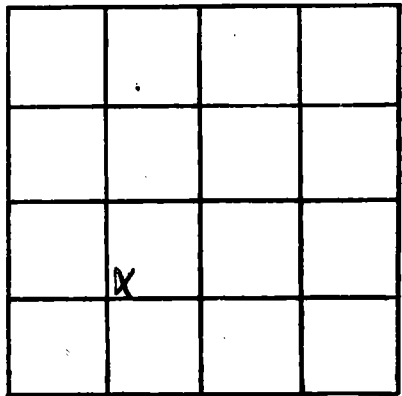

SECTION 34

Please indicate well location X.

ADDITIONAL INFORMATION

If more than one screen, show locations of each on sketch.