

MISSISSIPPI DEPARTMENT OF NATURAL RESOURCES
Bureau of Land and Water Resources
 Southport Mall
 P.O. Box 10631
 Jackson, Mississippi 39209
WATER WELL DRILLERS LOG

Jackson
M 2128

10-27 1984 Coast Water Well Sew. Jackson
 date well completed firm name county well located

LANDOWNER John Young
13237 Oak Haven Dr.
Pas. Miss.
 (mailing address) 39567

description of formations encountered	from	to
<u>Red Clay</u>	<u>0</u>	<u>16'</u>
<u>Med. Sand</u>	<u>16'</u>	<u>50'</u>
<u>Fine Gravel</u>	<u>50'</u>	<u>60'</u>
<u>Coarse sand</u>	<u>60'</u>	<u>172'</u>
<u>5'-2" Tail Pipe</u>		

WELL LOCATION:
 sec 9 T 6 R 5
3 miles NE of HEKNA
 (distance) (direction) (nearest town)

WELL PURPOSE: Home
 (home, irrigation, municipal, industrial)

- WELL COMPLETION DATA:
- (1) diameter (inches) 2"
 - (2) total depth (feet) 172'
 - (3) static water level (feet) 16' below top of ground above
 - (4) casing PVC, 162'
 (material) (depth)
2" If telescope see back.
 (size)
 - (5) screen 10', 162'
 (length) (depth to top)
2" PVC
 (size) (material)
 - (6) pump _____ (HP) _____ (yield gpm)
Eli's
 (type power)
 - (7) electric log No.
 (yes or no)


 (organization running log)
 - (8) how well bottom plugged backwash valve

1-8-85
240

DRILLERS REMARKS:

If well telescopes please sketch and show depths.

GROUND LEVEL

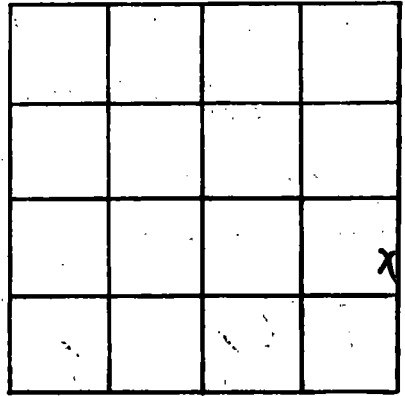

SECTION 9

Please indicate well location X.

ADDITIONAL INFORMATION

If more than one screen,
show locations of each on sketch.