

MISSISSIPPI DEPARTMENT OF NATURAL RESOURCES
Bureau of Land and Water Resources
 Southport Mall
 P.O. Box 10631
 Jackson, Mississippi 39209
WATER WELL DRILLERS LOG

Jackson
 M 2134

11-30-84 19 Coast Water Well Serv. Jackson
 date well completed firm name county well located

LANDOWNER: Phillip Horn
9336 Inzer St.
Madison, Miss.
 (mailing address) 39567

WELL LOCATION:
 sec. 31 T. 6 S. R. 4 W.
4 miles SE of HELENA
 (distance) (direction) (nearest town)

WELL PURPOSE: None
 (home, irrigation, municipal, industrial)

WELL COMPLETION DATA:

(1) diameter (inches) 2"

(2) total depth (feet) 165'

(3) static water level (feet) 10' below top of ground.

(4) casing PVC, 155'
 (material) (depth)

2" If telescope see back.
 (size)

(5) screen 10', 155'
 (length) (depth to top)

2" PVC
 (size) (material)

(6) pump 1 hp., 14
 (HP) (yield gpm)

Electric
 (type power)

(7) electric log No
 (yes or no)

—
 (organization running log)

(8) how well bottom plugged
Back Wash Valve


description of formations encountered	from	to
<u>Red Clay</u>	<u>0</u>	<u>10</u>
<u>Coarse sand</u>	<u>10'</u>	<u>55'</u>
<u>Gray Clay</u>	<u>55'</u>	<u>65'</u>
<u>Coarse sand</u>	<u>65'</u>	<u>83'</u>
<u>Blue Clay</u>	<u>83'</u>	<u>110'</u>
<u>Med. Sand</u>	<u>110'</u>	<u>165'</u>
<u>2'-2" Tail Pipe</u>		

1-8-85
gsw

DRILLERS REMARKS:

If well telescopes please sketch and show depths.

GROUND LEVEL

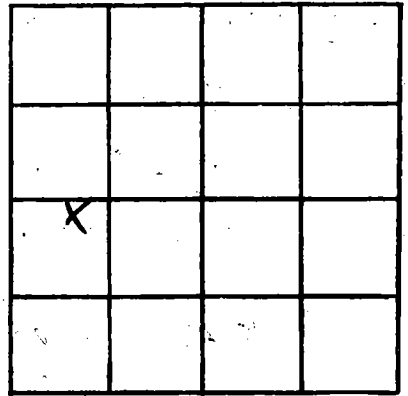

SECTION 31

Please indicate well location X.

ADDITIONAL INFORMATION

If more than one screen, show locations of each on sketch.