

MISSISSIPPI DEPARTMENT OF NATURAL RESOURCES
Bureau of Land and Water Resources
 Southport Mall
 P.O. Box 10631
 Jackson, Mississippi 39209
WATER WELL DRILLERS LOG

M 2136
JACKSON
1-19-85

1-19-85 19 Coast Water Well Sew Jackson
 date well completed firm name county well located

LANDOWNER: John Ledbetter
P.O. Box 952
Pascagoula, Miss.
 (mailing address) 39567
WELL LOCATION:
 sec. 6 T. 6 N. R. 5 W.
4 miles SW of Big Point
 (distance) (direction) (nearest town)

WELL PURPOSE:
 (home, irrigation, municipal, industrial)

WELL COMPLETION DATA:

(1) diameter (inches) 2"

(2) total depth (feet) 220'

(3) static water level (feet) 35' below above
 top of ground.

(4) casing PVC, 210'
 (material) (depth)
2"
 (size) if telescope see back.

(5) screen 10', 210'
 (length) (depth to top)
2", PVC
 (size) (material)

(6) pump 1 hp., 9 1/2
 (HP) (yield gpm)
 (type power)

(7) electric log no
 (yes or no)
 (organization running log)

(8) how well bottom plugged
Back Wash Valve

description of formations encountered	from	to
<u>Red Clay</u>	<u>0</u>	<u>3'</u>
<u>Drainy Clay</u>	<u>3'</u>	<u>13'</u>
<u>Sand</u>	<u>13'</u>	<u>85'</u>
<u>Sand & Sea Groul</u>	<u>85'</u>	<u>145'</u>
<u>Blue Clay</u>	<u>145'</u>	<u>170'</u>
<u>Sand</u>	<u>170'</u>	<u>220'</u>


RECEIVED
 APR 25 1985

DRILLERS REMARKS:

Department of Natural Resources
 Bureau of Land & Water Resources

If well telescopes please sketch and show depths.

GROUND LEVEL

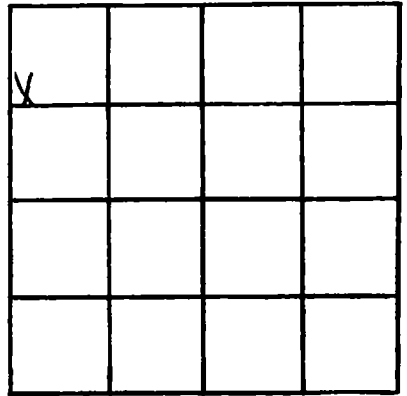

SECTION 6

Please indicate well location X.

ADDITIONAL INFORMATION

Multiple horizontal lines for additional information.

If more than one screen, show locations of each on sketch.